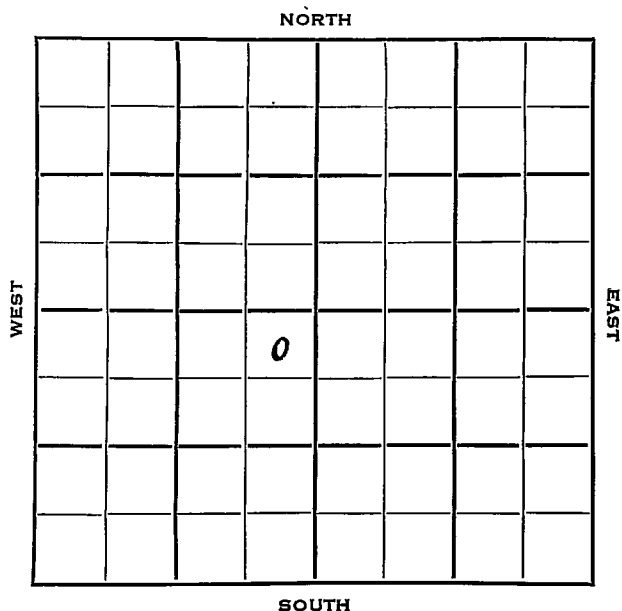


Section 24 Township 18 Range 10 WWell No. # 3 CulbertsonCompany Vickers Explor. Ltd.

Rice


KANSAS

Sec. 24 Twp. 18 R. 10WWell No. #3 Culbertson FarmVickers Explor. Ltd. CompanyJayhawk Drlg. Contractor

Farmer Pool

330 Ft. from N. Line Ft. from S. Line330 Ft. from E. Line Ft. from W. Line

NE NE SW

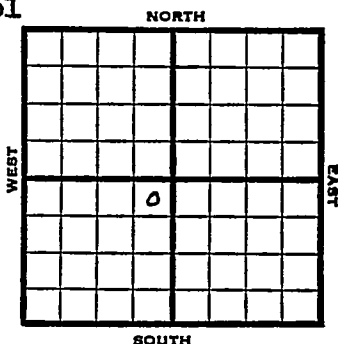

1953 Elev. 1742' REPORT

7/1 Spud 6-26-53
Drlg 1730'7/8 8" @ 210 w/160
Anhy 425, Heeb 2757, Tor 2786, Doug
2801, Br li 2879, Lans 2898, Arb 3237,
RTD 3241
5" @ 32387/22 CO 3243, FU 5' fluid, DD 3245 TD
No inc., 15/3238-43, 1000A
FU 2 bo 14 hrs.,
A-frac
S/5 bo + 20 bwph, POP

7/29 NR

8/5 NR

8/12 "

8/19 Spud 6-26-53
Oil Well
TD 3245'
8" @ 210'Anhy 425, Heeb 2757, Tor 2786, Doug
2801, Br. Lime 2879, Lans 2898, Arb
3237,
TD 3243'
5" @ 3238'

OVER

1953

Information brought forward.

8/19

CO to 3243'

FU 5' fluid DD 3245

15/ 3238-43 1000 A FU 2 bo
14 hr. .


A-frac S/ 5 bo 20 bwph

Comp. 43 bopd 35% wtr.

COMPLETED

J. G. McGEHEE

County Rice State Kansas
 Sec. 24 (Blk. 18 (Sur. 10W Map No.
 (Twp.) (Rge.)
 Operator Vickers Explor. Ltd.
 Well No. 3 Farm Culbertson
 Elev. 1742 Location NE NE SW

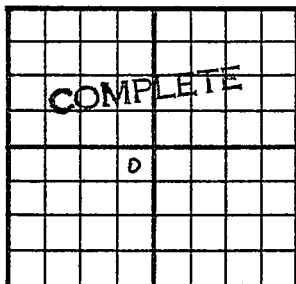

330 Ft. From N Line SW
330 Ft. From E Line Quarter
 1st. Report
 Completion AUG 19 1953
 Remarks Farmer Pool
Jayhawk Drlg. - Contr.
 Spudding Date 6-26-53

Drlg. Data Oil well TD 3245
8" @ 210 Anhy 425 Heeb. 2757
Tor. 2786 Doug. 2801 Br. lime 2879
Lans. 2898 Arb. 3237 TD 3243
5" @ 3238 CO to 3243 FU 5' fluid
DD 3245. 15/ 3238-43 1000 A FU 2 bo
14 hr. A-frac S/ 5 bo 20 bwph
Comp. 43 bopd .35% wtr.

J. G. McGEHEE