


24**18****10W**

Section _____ Township _____ Range _____

Well No. **#4 Bredfeldt**Company **Nadel & Gussman**

NORTH

WEST

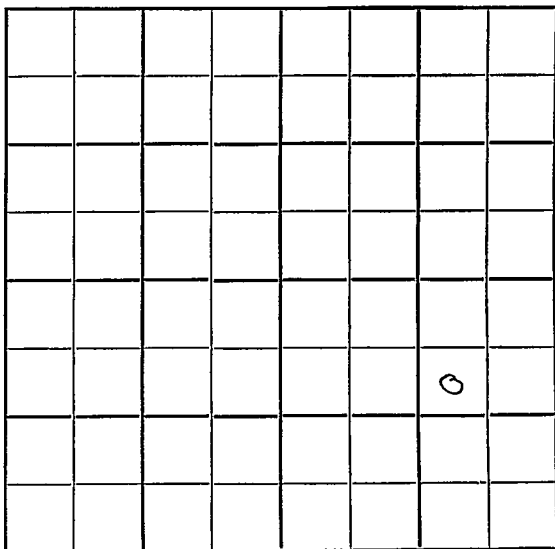

EAST

SOUTH

Rice

KANSAS

Sec. 24 Twp. 18 R. 10W

Well No. #4 Bredfeldt Farm

Nadel & Gussman
Company

Nadel & Gussman
Farmer Contractor

Farmer


990 _____ Ft. from N. Line

Ft. from S. Line

990 _____ Ft. from E. Line

Ft. from W. Line

SW NE SE

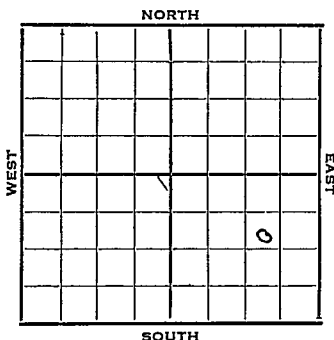

1952	Elev. 1732'	REPORT
------	-------------	--------

8/20 | RU

8/27	8" @ 200 Anhy 417 Dr1g. 2776'
------	-------------------------------------

9/3 Heeb. 2743 Lans. 2890
 Cong. 3212 Arb. 3214
 RTD 3224' 5" @ 3218'

9/10	DD 3225'	TD 500 A	S/L BOPH
	1000 A	S/60 BOPH	POP

9/17 NR

9/24 Spud 8-19-52
Oil Well TD 3225' 8" @ 200'
Anhy 417 Heeb. 2743
Lans. 2890 Cong. 3212
Arb. 3214
TD 3224 5" @ 3218 DD 3225
500 A S/ 4 boph 1000 A S/ 60 boph
Comp. 1910 bopd 3% wtr.


COMPLETED

County Rice State Kansas
 Sec. 24 (Blk. Twp.) 18 (Sur. Rge.) 10W Map No.

Operator Nadel & Gussman

Well No. 4 Farm Bredfeldt

Elev. Location SW NE SE

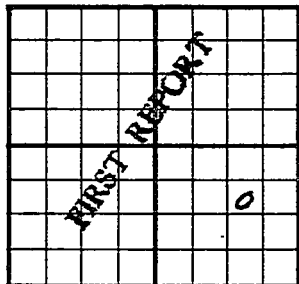

990 Ft. From N Line SE

990 Ft. From E Line Quarter

1st. Report AUG 20 1952

Completion

Remarks


Nadel & Gussman - Contr.

Spudding Date

Drlg. Data Farmer

RU

J. G. McGEHEE

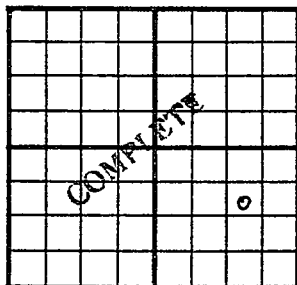County Rice State KansasSec. 24 (Blk. 18 (Sur. 10W Map No.)
(Twp.) (Rge.)Operator Nadel & GussmanWell No. 4 Farm BredfeldtElev. 1732 Location SW NE SE990 Ft. From N Line SE990 Ft. From E Line Quarter1st. ReportCompletion SEP 24 1952Remarks Farmer PoolNadel & Gussman - Contr.Spudding Date 8-19-52Drig. Data Oil well TD 32258" @ 200 Anhy 417 Heeb. 2743Lans. 2890 Cong. 3212 Arb. 3214TD 3224 5" @ 3218 DD 3225 500 AS/ 4 boph 1000 A S/ 60 bophComp. 1910 bopd 3% wtr.