


Section 24 Township 18 Range 10 W

Well No. # 8 Bredfeldt

Company Nadel & Gussman

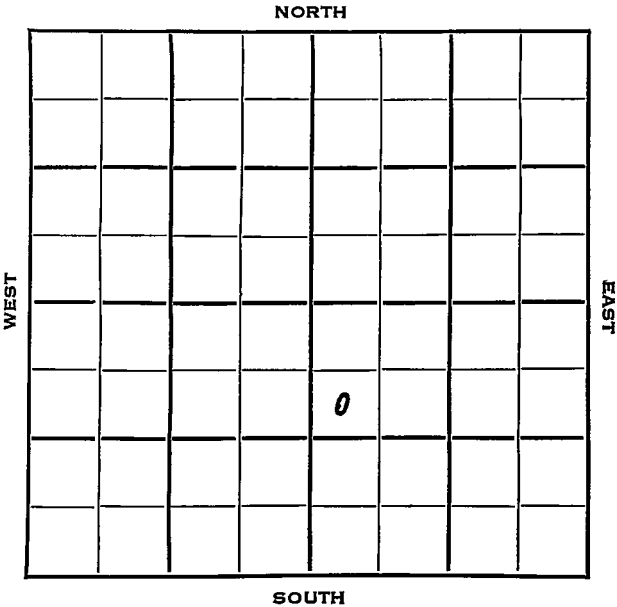


Rice

KANSAS ✓

Sec. 24 Twp. 18 R. 10WWell No. #8 Bredfeldt FarmNadel & Gussman CompanyReserve Drlg. ContractorFarmer Pool990 Ft. from N. Line Ft. from S. Line Ft. from E. Line330 Ft. from W. Line

SW NW SE

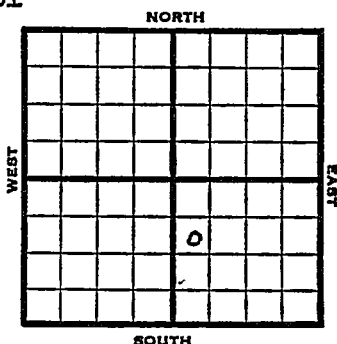

1953 Elev. 1739' REPORT

- 8/5 Spud 7-31-53
8-5/8" @ 160'
Anhy 423'
Drlg 1875'
- 8/12 Heeb 2753, Br li 2874, ^Lans 2898
DST 2980-3005, 1 hr., 540' gas, 70'
GCM, 180' SW, 910#
Cong 3218, Arb 3231,
R TD 3236
5" @ 3233
- 8/19 DD 3238, 200' oil, 12 hrs.
DD 3239, 1/3238
- 8/26 500 A Sq CO
- 9/2 CO 3239
500 A S/ 5 boph POP
- 9/9 N.R.
- 9/16 "
- 9/23 Spud 7-31-53
Oil Well
TD 3239'
8-5/8" @ 160'
Anhy 423, Heeb 2753, Br. Lime 2874,
Lans 2898'

OVER

County Rice State Kansas

Sec. 24 (Blk. Twp.) 18 (Sur. Rge.) 10W Map No.

Operator Nadel & Gussman

Well No. 8 Farm Bredfeldt

Elev.	1739	Location	SW NW SE
-------	------	----------	----------

990 Ft. From N Line SE

330 Ft. From W Line Quarter

1st. Report

Completion SEP 23 1953

Remarks	Farmer Pool
---------	-------------

Reserve Drlg. - Contr.

Spudding Date 7-31-53

Drig. Data Oil well TD 3239

8 5/8" @ 160 Anhy 423 Heeb. 2753

Br. lime 2874 Lans. 2898 DST 2980-3005

open 1 hr. Rec. 540' gas 90' gcm

180' SW 910# Cong. 3218 Arb. 3231

TD 3236 5" @ 3233 DD 3238 FU 200' oil

12 hr. DD 3239 1/ 3238 500 Å

CO to 3239 500 A S/ 5 boph

Comp. 95 bopd

J. G. McGEHEE

1953

Information brought forward.

9/23 DST 2980-3005' opn 1 hr, rec 540' gas,
90' gcm, 180' sw, 910# Cong 3218'
Arb 3231',
TD 3236'
5" @ 3233' .
DD 3238'
FU 200' oil 12 hr.
DD 3239'
1/ 3238 500 A
CO to 3239
500 A S/ 5 boph
Comp. 95 bopd.

COMPLETED