


Section 24 Township 18 Range 26 W

Well No. # 2 Sutton "A"

Company C R A

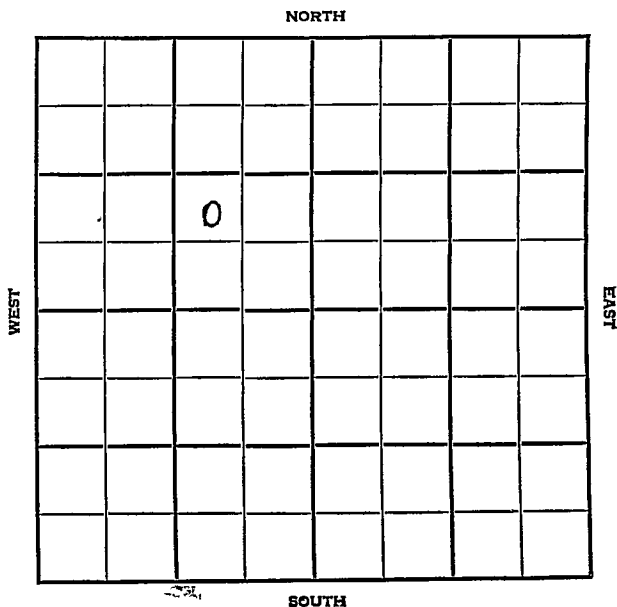

Ness KANSAS

SEC.	TWP.	R.
24	18	26W

WELL NO. 2 Sutton "A" FARM

COMPANY C R A

CONTRACTOR C R A

Aldrich Pool


_____ Ft. from N. Line

990 _____ Ft. from S. Line

990 _____ Ft. from E. Line

_____ Ft. from W. Line

NW SE NW

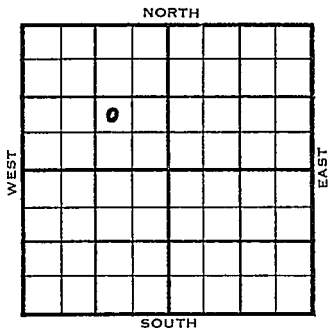

	ELEVATION	REPORT
1955		

3/16 Location

