

KANSAS

Rice

Section 23 Township 18 Range 10WWell No. 1 SchultzCompany Eldorado Ref.

Orth Pool

NORTH

WEST

EAST

			0				

SOUTH

KANSAS

Rice

Sec. 23 Twp. 18 R. 10W ✓

Well No. #1 Schultz Farm

Eldorado Ref. Company

Orth Pool


330' Ft. from N. Line

 Ft. from S. Line

330' Ft. from E. Line

 Ft. from W. Line

NE SW

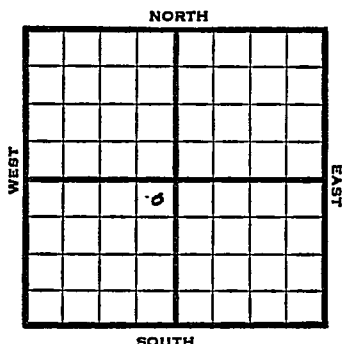

1949

Elev 1753' REPORT

2/23

Location

3/2

8" @ 174'

3/8

Drlg 700'

Lansing 2923'

Drlg 3130'

3/16

TD 3293'

Cong 3219'

Arb. 3278'

Aband.

ABANDONED

Kansas

Orth Pool

Map No. _____ Sec. 23 Twp. 18 R. 10WWell No. 1 Schultz

Eldorado Ref. _____ Company _____

FIRST REPORT Contractor _____

NE SW


SECTION PLAT

330 Ft. from N. Line

_____ Ft. from S. Line

330 Ft. from E. Line

_____ Ft. from W. Line

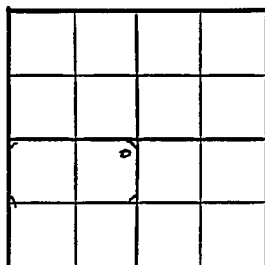

Rice County

Location X

Rig up _____

Drilling and Remarks: _____

RECORD

Cased _____ in., _____ ft.

Sand _____

Gas _____

Oil _____

Total Depth _____

PRODUCTION

1st 24 hrs. Nat. _____

1st 24 hrs. after shot _____

Gas _____ Cu. Ft.

Dry Hole _____

Abandoned _____

Date

FEB 23 1949 19S. J. LEWIS

Scout

Map No. 255 Sec. 23 Twp. 18 R. 10W

Well No. 1 Schultg

Eldorado Ref. Company

ABANDONED

Contractor

NE SW

E. I. 123


SECTION PLAT

330 Ft. from N. Line

 Ft. from S. Line

330 Ft. from E. Line

 Ft. from W. Line

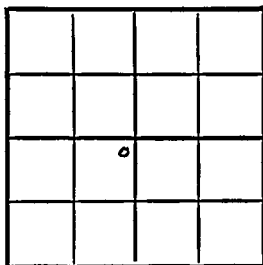

Rice County

Location

Rig up

Drilling and Remarks:

Comp 3219
Cur 3278

RECORD

Cased in., ft.

Sand

Gas

Oil

Total Depth 3223

PRODUCTION

1st 24 hrs. Nat.

1st 24 hrs. after shot

Gas Cu. Ft.

Dry Hole

Abandoned

Date

MAR 16 1949 19

S. J. LEWIS Scout