


Section 23 Township 18 Range 10W

Well No. #1 Spotts

Company Hinkle Oil

Orth Pool

NORTH

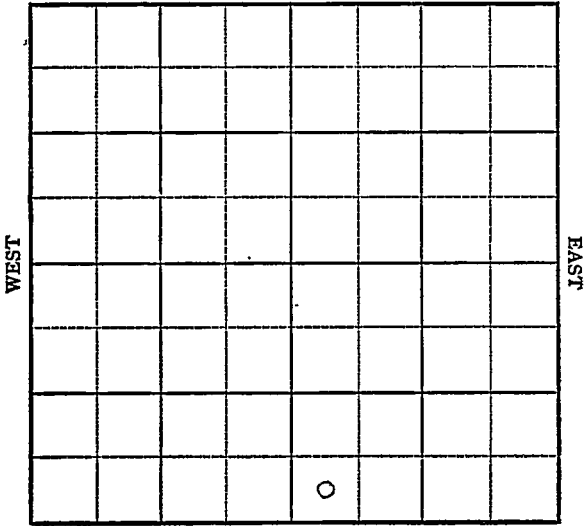

SOUTH

Sec. 23 Twp. 18 R. 10-W

Well No. #1 Spotts Farm


Hinkle Oil Company
Orth Pool

_____ Ft. from N. Line

330 Ft. from S. Line

_____ Ft. from E. Line

330 Ft. from W. Line

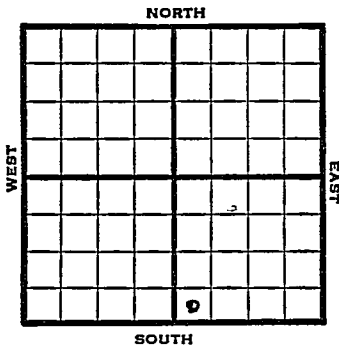

SW SE

1948	Eli 1751'	REPORT
10/13	8" @ 184	
	Anhy 430	
	Drlg 3164'	
10/20	TD 3250'	
	Arb. 3235'	
	5" @ 3250'	
	24 shots 3245-50'	
	Pump 50 Oil Pot	
	41° Gr.	
	Comp	
	COMPLETED	

Map No. _____ Sec. 23 Twp. 18 R. 10W

Well No. 1 Spotts

Hinkle Oil Company

FIRST REPORT

Contractor _____

SW SE

SECTION PLAT

_____ Ft. from N. Line

330 Ft. from S. Line

_____ Ft. from E. Line

330 Ft. from W. Line

Rice County

Location _____

Rig up _____

Drilling and Remarks:

8" @ 184

Anhy 430

drig. 3164

RECORD

Cased _____ in., _____ ft.

Sand _____

Gas _____

Oil _____

Total Depth _____

PRODUCTION

1st 24 hrs. Nat. _____

1st 24 hrs. after shot _____

Gas _____ Cu. Ft.

Dry Hole _____

Abandoned _____

Date

OCT 13 1948 19

S. J. LEWIS Scout

