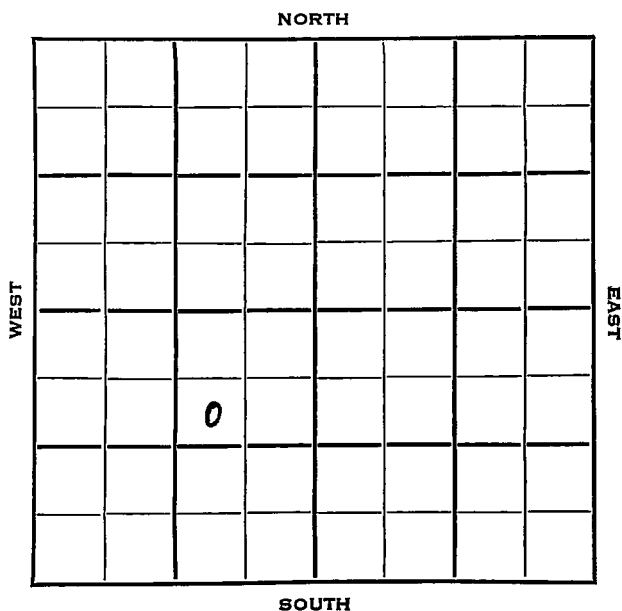


Section 24 Township 18 Range 10 WWell No. # 2 CulbertsonCompany Vickers Explor. Ltd.

KANSAS

Sec. 24 Twp. 18 R. 10W

Well No. #2 Culbertson Farm

Vickers Explor. Ltd. Company

Jayhawk Drlg. Contractor

Farner Ext.


990 Ft. from N. Line

Ft. from S. Line

990 Ft. from E. Line

Ft. from W. Line

SW NE SW

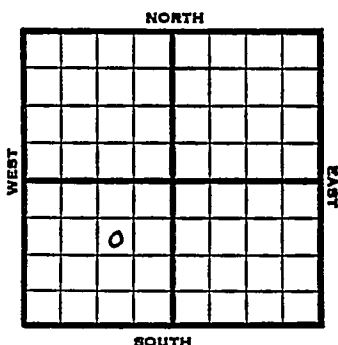

1953 | Elev. 1741' | REPORT

6/24 Spud 6-17-53
8" @ 207'
Anhy 420'
Dr1g 2788'

7/1 Heeb 2744, Tor 2773, Doug 2791, Br. L.
2866, Lans 2886, Cong 3212, Arb 3230,
DST 3232-37 2 hrs, 100' oil, 746#
RTD 3237
5" @ 3231'

7/8 DD 3239, S/6½ BOPH 500A, no inc. POP

7/22 NR

7/29 "

8/5 Spud 6-17-53
Oil Well
TD 3239'
8" @ 207'
Anhy 420, Heeb 2744, Tor 2773, Doug
2791, Br. Lime 2866, Lans 2886, Cong
3212, Arb 3230,
DST 3232-37 opn 2 hr, rec 100' oil
746#
TD 3237'
5" @ 3231'
DD 3239 S/ 6½ boph 500 A
Comp. 215 bopd.

COMPLETED



Operator Vickers Explorer, Ltd.

Well No. 2 Farm Gulbertson

Elev.	Location	SW	NE	SW
-------	----------	----	----	----

FIRST REPORT

990 Ft. From N Line SW

990 Ft. From E Line Quarter

1st. Report **JUN 24 1953**

Completion

Remarks

Jayhawk Drig. - Contr.

Spudding Date **6-17-53**

Drig. Data	Farner Ext.
1	1
2	2
3	3
100	100

8th @ 207 Anhv 420 drlg. 2788

J. G. McGEHEE

County	Rice	State	Kansas
Sec.	24	(Blk. Twp.) 18	(Sur. Rge.) 10W Map No.
Operator	Vickers Explor. Ltd.		
Well No.	2	Farm	Culbertson
Elev.	1741	Location	SW NE SW

COMPLETE

0

990 Ft. From	N Line	SW
990 Ft. From	E Line	Quarter
1st. Report		
Completion	406	5 1953
Remarks	Farner Ext.	
Jayhawk Drlg. - Contr.		
Spudding Date	6-17-53	

Drlg. Data	Oil well	TD 3239
8" @ 207	Anhy 420	Heeb. 2744
Tor. 2773	Doug. 2791	Br. lime 2866
Lans. 2886	Cong. 3212	Arb. 3230
DST 3232-37	open 2 hr.	Rec. 100' oil
746#	TD 3237	5" @ 3231 DD 3239
S/ 6 $\frac{1}{2}$ boph	500 A	Comp. 215 bopd

J. G. McGEHEE