

Section 24 Township 18 Range 10W
Well No. #4 Culbertson
Company Vickers Expl. Ltd.

NORTH

WEST

EAST

0

SOUTH

Rice
18

KANSAS

Sec. 24 Twp. R. 10W

Well No. #4 Culbertson Farm

Vickers Expl. Ltd. Company

Jayhawk Farmer Contractor


Ft. from N. Line

990 Ft. from S. Line

Ft. from E. Line

990 Ft. from W. Line

NE SW SW

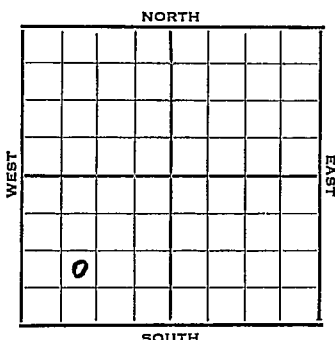

1953 Elev. 1746' REPORT

7/8 Spud 7-6-53
8" @ 212 w/160, WOC

7/22 NR

7/29 NR

8/12 "

8/19 Spud 7-6-53
Oil Well
TD 3242'
8" @ 212'
Heeb 2747, Br. Lime 2870, Lans 2890,
Cong 3213, Arb 3232,
DST 3234-39 opn 3/4 hr, rec 240'
gas 100' oil 80' ocm 605#
TD 3239'
5" @ 3234'
DD 3241
FU 1450' oil 12 hr. S/ 3 boph DD
3242 S/ 3 1/2 boph
Comp/ 112 bopd.

COMPLETED

County Pike State Kansas

Sec. 24 (Blk. 18 (Sur. 10W Map No.

Operator **Vickers Expl. Ltd.**

Well No. 4 Farm Culbertson

Elev.	Location	NE	SW	SW
-------	----------	----	----	----

FIRST REPORT

0

990 Ft. From S Line SW

990	Ft. From	W	Line	Quarter
-----	----------	---	------	---------

1st. Report **JUL 8 1953**

Completion

Remarks

Jayhawk - Contr.

Spudding Date 7-6-53

Drig. Data Farmer

8" @ 212 w/160 WOC

L.G. McGEHEE

J. G. McGEHEE