


Section **24** Township **18** Range **10W**

Well No. **#5 Bredfeldt**

Company **Nadel & Gussman**

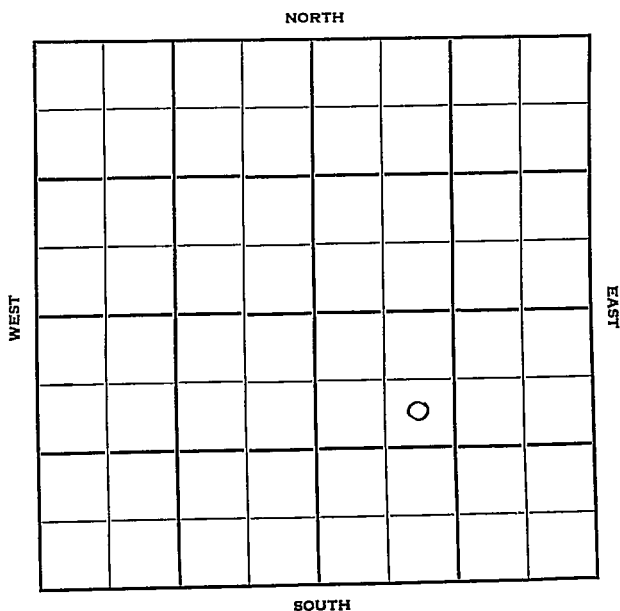

Sec. 24 Twp. 18 R. 10WWell No. #5 Bredfeldt FarmNadel & Gussman Company

Reserve

Contractor

990

Ft. from N. Line


Ft. from S. Line

Ft. from E. Line

990

Ft. from W. Line

SE NW SE

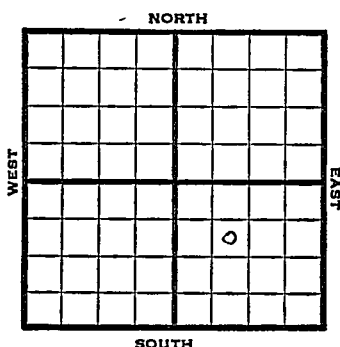

1952

Elev. 1735' REPORT

9/10

RU

9/17

8" @ 210 Drlg. 2778'

9/24

Heeb 2747' Lans 2883' Cong 3197'
Arb. 3215' RTD 3219' 5" @ 3216'

10/1

CO 3226' 15 gal O 1 1/4 hrs. 1000 A
5 gal OPH DD 3232' TD St-lift
1-3/4 BOPH 1500 A

10/8


S/15 BOPH
POP

10/15

"

10/22

Spud 9-9-52
Oil Well
TD 3232'
8" @ 210'
Heeb 2747', Lans 2883', Cong. 3197',
Arb. 3222'
TD 3226'
5" @ 3223
GO to 3226 15 go 1 1/4 hr., 1000A
5 goph DD 3232 stratolift
1 3/4 boph 1500A S/15 boph
Comp. 166 bopd**COMPLETED**

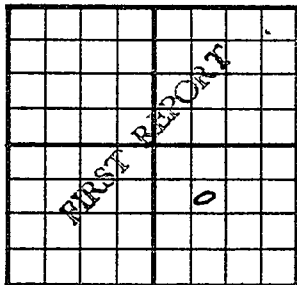County Rice State KansasSec. 24 (Blk. Twp.) 18 (Sur. Rge.) 10W Map No.Operator Nadel & GussmanWell No. 5 Farm BredfeldtElev. Location SE NW SE990 Ft. From N Line SE990 Ft. From W Line Quarter1st. Report SEP 10 1952

Completion

Remarks


Reserve - Contr.

Spudding Date

Drlg. Data FarmerRU

J. G. McGEHEE

County Rice State Kansas
 Sec. 24 (Blk.) 18 (Sur.) 10W Map No. (Twp.)
 Operator Nadel & Gussman
 Well No. 5 Farm Bredfeldt
 Elev. 1735 Location SE NW SE

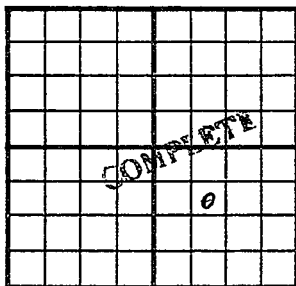

990 Ft. From N Line SE
990 Ft. From W Line Quarter
 Ist. Report
 Completion OCT 22 1952
 Remarks Farmer Pool
Reserve Drlg. - Cntr.
 Spudding Date 9-9-52

Drlg. Data Oil well TD 3232
8" @ 210 Heeb. 2747 Lans. 2883
Cong. 3197 Arb. 3222 TD 3226
5" @ 3223 CO to 3226 15 go 14 hr.
1000 A 5 goph DD 3232 stratolife
1 3/4 boph 1500 A S/ 15 boph
Comp. 166 bopd

J. G. McGEHEE