


Section 24 Township 18 Range 10W

Well No. #6 Bredfeldt

Company Nadel & Gussman

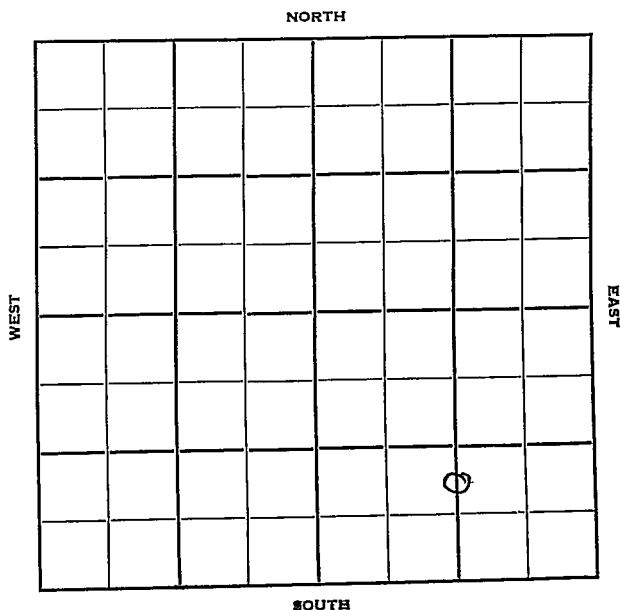


1st ELV-

173 ✓

Rice

KANSAS

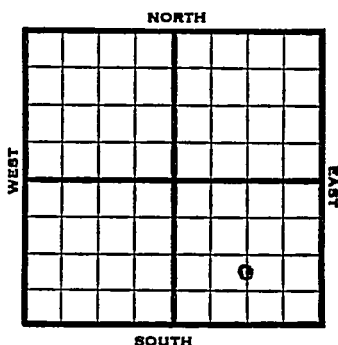Sec. 24 Twp. 18 R. 10WWell No. #6 Bredfeldt FarmNadel & Gussman Company Contractor Ft. from N. Line990 Ft. from S. Line1320 Ft. from E. Line Ft. from W. LineSE $\frac{1}{4}$ C N $\frac{1}{2}$ S $\frac{1}{2}$ SE

1952 Elev. 1732' REPORT

11/12 Spud 11-7-52
 8" @ 179'
 Anhy 420'
 Drlg. 1210'

11/20 Heeb 2743' Lans 2890' Arb. 3214'
 TD 3225' 5" @ 3221'

11/27 NR

12/4 "

12/11 CO 3225 FW 150 Oil 1000A

12/18 6 BOPH 50% Wtr POP

12/25 " " " "

1/1 NR

1/8 NR

1/14 Spud 11-7-52
 Oil Well TD 3225
 8" @ 179'
 Anhy 420, Heeb 2743, Lans 2890,
 Arb. 3214
 TD 3225
 5" @ 3221, CO to 3225 FU 150'
 oil 1000A 6 boph 50% wtr.
 Comp. 76 bopd 25% wtr.

COMPLETED

County Rice State KansasSec. 24 (Blk.) 18 (Sur.) 10W Map No.Operator Nadel & GussmanWell No. 6 Farm BredfeldtElev. Location C N $\frac{1}{2}$ S $\frac{1}{2}$ SE990 Ft. From S Line SE1320 Ft. From E Line Quarter1st. Report NOV 12 1952

Completion


Remarks

Spudding Date 11-7-52

Drlg. Data

8" @ 179 Anhy 420 drlg. 1210

County Rice State Kansas
 Sec. 24 (Blk. 18 (Sur. 10W Map No.
 (Twp.) (Rge.)
 Operator Nadel & Gussman
 Well No. 6 Farm Bredfeldt
 Elev. 1732 Location C N $\frac{1}{2}$ S $\frac{1}{2}$ SE

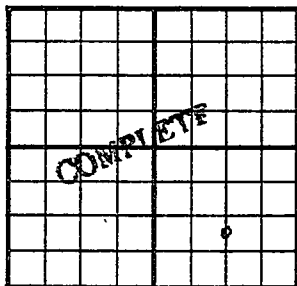

990Ft. From S Line SE
1320Ft. From E Line Quarter

1st. Report

Completion JAN 14 1953

Remarks

Spudding Date 11-7-52

Drlg. Data Oil well TD 3225

8" @ 179 Anhy 420 Heeb. 2743

Lans. 2890 Arb. 3214 TD 3225

5" @ 3221 CO to 3225 FU 150' oil

1000 A 6 boph 50% wtr.

Comp. 76 bopd 25% wtr.

J. G. McGEHEE