


Section 25 Township 18 Range 10W
 Well No. #1 PLAUTZ Schultz
 Company Nadel & Gussman

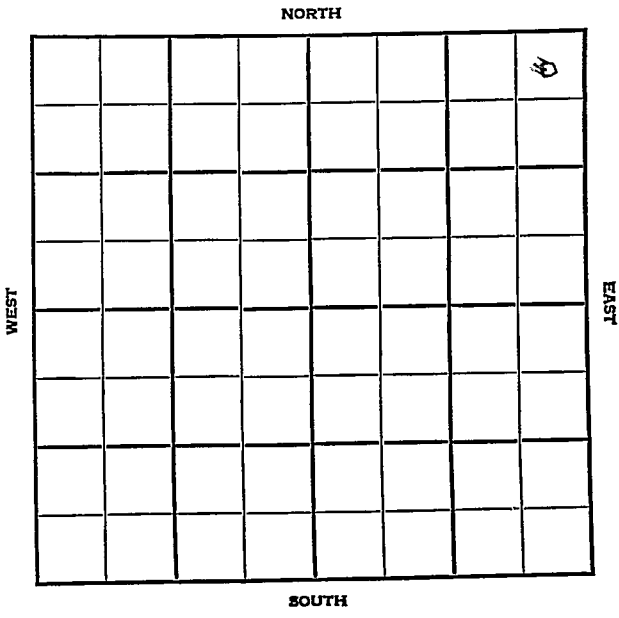

O.W.W.O. KANSAS

Sec. 25 Twp. 18 R. 10W

Well No. #1 Schultz Farm

Nadel & Gussman Company
Orth


330 Ft. from N. Line

 Ft. from S. Line

330 Ft. from E. Line

 Ft. from W. Line

NE/C

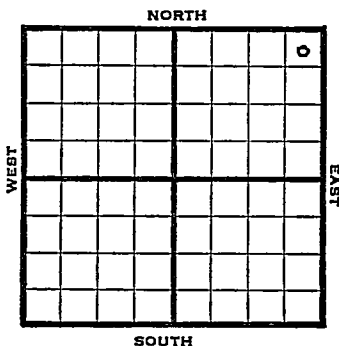

1948 Elev. 1723' REPORT

- 1/28 Location
- 2/4 8" @ 210'
WOC
- 2/11 Drlg. 3009'
- 2/18 Lans. 2871'
Arb. 3212'
TD 3260'
Abd.

ABANDONED

O.W.W.O.

- 1952
8/20 KC 2871 Cong. 31883
Arb. 3212
OTD 3262 D&A CO 3262
5" @ 3262
- 8/27 108/3219-32 A-frac 1/2 BO & 4 BWPB
- 9/3 NR
- 9/10 "
- 9/17 34/3236-42 1250 A 4 BWPB PB 3010'
54/2956-62 1000 A 1 M gas.
CO Sq off CO 3260' 71/3212-18
500 A Set packer to A
- 9/24 NR
- 10/1 D&A RD 3262' KC 2871
Cong. 3188 Arb. 3212

OVER

1952

10/1 OTD 3262 CO to 3262 5" @ 3262
108/ 3219-32 A-Frax. $\frac{1}{2}$ bo 4 bwph
34/ 3236-42 1250A 4 bwph
PB 3010 54/ 2956-62 1000 A
1 mcfg CO 3260 71/ 3212-18
500 A wtr. D&A

ABANDONED

Map No. _____ Sec. 25 Twp. 18 R. 10W

Well No. 1 Schultz

Nadel & Gussman Company

FIRST REPORT Contractor

NE/C

SECTION PLAT

330 Ft. from N. Line

_____ Ft. from S. Line

330 Ft. from E. Line

_____ Ft. from W. Line

			o

Rice County

Location X

Rig up _____

Drilling and Remarks:

RECORD

Cased _____ in., _____ ft.

Sand _____

Gas _____

Oil _____

Total Depth _____

PRODUCTION

1st 24 hrs. Nat. _____

1st 24 hrs. after shot _____

Gas _____ Cu. Ft.

Dry Hole _____

Abandoned _____

Date

JAN 28 1948 19

S. J. LEWIS Scout

Map No. 55 Sec. 25 Twp. 18 R. 10W

Well No. 1 Schultz

Nadel & Gussman Company

ABANDONED Contractor

NE/C

E 11 1928
SECTION PLAT

330 Ft. from N. Line

 Ft. from S. Line

330 Ft. from E. Line

 Ft. from W. Line

			4

Rice County

Location _____
 Rig up _____
 Drilling and Remarks:
Log 2871
CR 23212

RECORD

Cased _____ in., _____ ft.
 Sand _____
 Gas _____
 Oil _____
 Total Depth 2260

PRODUCTION

1st 24 hrs. Nat. _____
 1st 24 hrs. after shot _____
 Gas _____ Cu. Ft.
 Dry Hole _____
 Abandoned _____

Date

FEB 18 1948 19

S. J. LEWIS Scout

County Rice State Kansas

Sec. 25 (Blk. 18 (Sur. 10W (Twp.) (Rge.) Map No.

Operator Nadel & Gussman

Well No. 1 Farm Plautz

Elev. 1723 Location NE NE NE

					0

FIRST REPORT

330 Ft. From N Line NE

330 Ft. From E Line Quarter

1st. Report AUG 20 1952

Completion _____

Remarks OWFO O.W.W.U.

Spudding Date _____

Drig. Data _____

KC 2871 Cong 3188 Arb 3212 OTD 3262

D&A CO 3262 5" @ 3262

