

KANSAS

FORM 51 5M 1-42 PETROL

Russell

Section 13 Township 13 Range 15-W

Well No. #1 Jellison

Company Texas

NORTH

							0

SOUTH

WEST

EAST

KANSAS

Russell

Sec. 13 Twp. 13 R. 15-W

Well No. #1 Jellison Farm
Texas Company


330 Ft. from N. Line

 Ft. from S. Line

330 Ft. from E. Line

 Ft. from W. Line

Elv. 1792

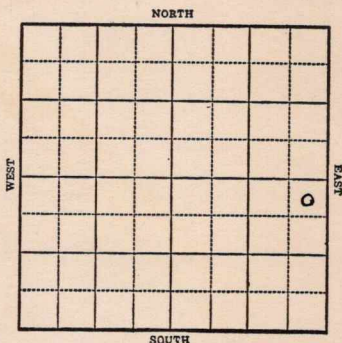

1943

R E P O R T

5/5 Location

5/12 "

5/19 8" @ 855' WOC.

5/26 D_nlg. 2195'

6/2 **Lans 2970**
Network Arb 3233
Arb 3244
T.D. 3253 SD

6/9 **Arb. 3244**
T.D. 3253'
No shows.

ABANDONED

KANSAS

Russell

Map No. 72 Sec. 13 Twp. 13 R. 15WWell No. 1 JellisonTexas

Company

FIRST REPORT

Contractor

NE SE

SECTION PLAT

330


Ft. from N. Line

Ft. from S. Line

330

Ft. from E. Line

Ft. from W. Line

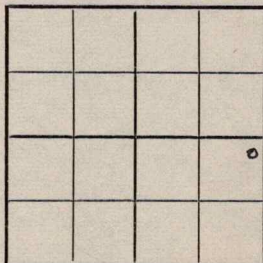

WILDCAT

Location XXX

Rig up

Drilling and Remarks:

RECORD

Cased _____ in., _____ ft.

Sand _____

Gas _____

Oil _____

Total Depth _____

PRODUCTION

1st 24 hrs. Nat. _____

1st 24 hrs. after shot _____

Gas _____ Cu. Ft.

Dry Hole _____

Abandoned _____

Date

MAY 5 1943 19

S. J. LEWIS

Scout

KANSAS

Russell

Map No. 12 Sec. 13 Twp. 13 R. 15WWell No. 1 Jellison

Texas

Company

ABANDONED

Contractor

NE SE

330 Ft. from N. Line

Ft. from S. Line

330 Ft. from E. Line

Ft. from W. Line

SECTION PLAT

			a

WILDCAT

Location

Rig up

Drilling and Remarks:

*Cr 83244**Noe holes*

RECORD

Cased _____ in., _____ ft.

Sand _____

Gas _____

Oil _____

Total Depth 3253

PRODUCTION

1st 24 hrs. Nat. _____

1st 24 hrs. after shot _____

Gas _____ Cu. Ft.

Dry Hole _____

Abandoned _____

Date

JUN 9 1943 19

S. J. LEWIS Scout