
Form 51—5M—4-27—27423

Map No. KANSAS Sec. 10 Twp. 13 R. 15w

Well No. 10 Cooks Farm

Gypsy Oil Company

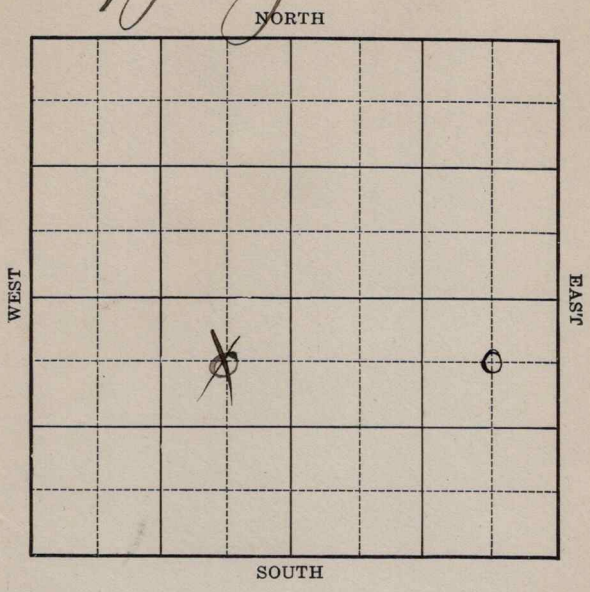

Location	Rig Up
Drilling Remarks	Drilling Remarks

RECORD		PRODUCTION	
Cased	in. ft.	1st 24 hrs. Nat.	
Sand		1st 24 hrs. after shot	
Gas		Gas	cu. ft.
Oil		Dry Hole	
Total Depth		Abandoned	

Form 252A—5M—4-27—27425

Map No. KANSAS Sec. 10 Twp. 13 R. 15w

Well No. 1 — Cooks Farm


Gypsy Oil Company

660 Ft. from N. Line

Ft. from S. Line

660 Ft. from E. Line

Ft. from W. Line

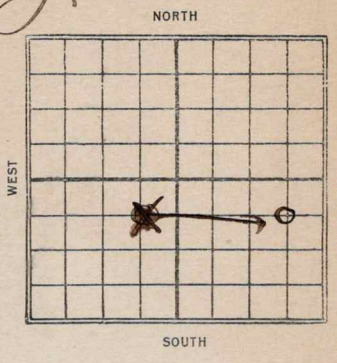

1928

Date	REPORT
7/11	Location
7/18	Bldg rig
7/25	Rig
8/1	Spud
8/7	Running 15" @ 360
8/15	drlg @ 660'
8/22	" 700
9/5	" 2455
9/12	" 2700
9/19	" 2986
9/26	sand 3064-90' HFW U/R 6" to 3095 T.D.
10/3	sand 3265-70' 10 bailers oil per hr.
10/10	T.D. 3337' U/R 6"
10/17	T.D. 3385' U/R 6"
10/24	Dry & Abd T.D. 3348' 3???

Form 26—1M Bks.—3-23—11959.

no map Russell


Map No. KANSAS Sec. 10 Twp. 13 R. 15W

Well No. 1 Crooks

Gypsy Oil Company

Contractor

SECTION PLAT

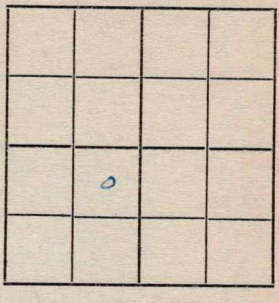

660 Ft. from N. Line

Ft. from S. Line

660 Ft. from E. Line

Ft. from W. Line

FIRST REPORTS

Location ✓

Rig up

Drilling and Remarks:

RECORD

Cased in., ft.

Sand

Gas

Oil

Total Depth

PRODUCTION

1st 24 hrs. Nat.

1st 24 hrs. after shot

Gas Cu. Ft.

Dry Hole

Abandoned

Date

JUL 11 1928

192

S. J. LEWIS Scout

Form 26—1M Bks.—3-23—11959.

Russell

KANSAS

Map No. ---------- Sec. 10 ---- Twp. 13 ---- R. 15W

Well No. 1 Cooks

Gypsy Oil Company

Contractor


SECTION PLAT

660 Ft. from N. Line

---- Ft. from S. Line

660 Ft. from E. Line

---- Ft. from W. Line

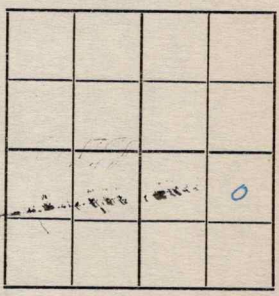

Correction

Location ----------

Rig up ----------

Drilling and Remarks:

Report this C NE SW. should be C NE SE.

RECORD

Cased ---- in., ---- ft.

Sand ----------

Gas ----------

Oil ----------

Total Depth ----------

PRODUCTION

1st 24 hrs. Nat. ----------

1st 24 hrs. after shot ----------

Gas ---------- Cu. Ft.

Dry Hole ----------

Abandoned ----------

Date

JUL 25 1928

192

S. J. LEWIS

Scout

FORM 26-250 BKS. 4-28 WESTERN

Russell
No transfer


MAP NO. _____ SEC. 10 TWP. 13 R. 15W

WELL NO. 1 Cooks

Gypsy Oil COMPANY

CONTRACTOR

SECTION PLAT

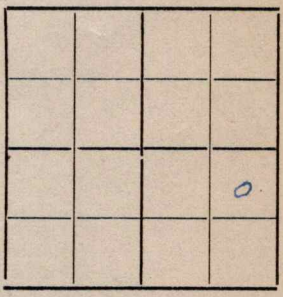

660 FT. FROM N. LINE

FT. FROM S. LINE

660 FT. FROM E. LINE

FT. FROM W. LINE

ABANDONED

LOCATION

RIG UP

DRILLING AND REMARKS:

D & A

RECORD

CASED IN., FT.

SAND

GAS

OIL

TOTAL DEPTH 3348

PRODUCTION

1ST 24 HRS. NAT.

1ST 24 HRS. AFTER SHOT

GAS Cu. FT.

DRY HOLE

ABANDONED

DATE

OCT 24 1928 192

S. J. LEWIS SCOUT