

Map No. K10 Sec. 35 Twp. 27 R. 8

Well No. S. P. Lewis
Empire Company
Contractor

NORTH

WEST

EAST

660 N 4 E SOUTH

Location _____
Rig up Machine
Drilling and Remarks:

FIRST REPORT

RECORD

Cased _____ in., _____ ft.
Sand _____
Gas _____
Oil _____
Total Depth _____


PRODUCTION

1st 24 hrs. Nat. _____
1st 24 hrs. after shot _____
Gas _____ Cu. Ft.
Dry Hole _____
Abandoned _____

Date 12/17 S. P. Lewis Scout
191 _____

Map No. K 10 Sec. 35 Twp. 27 R. 8

Well No. I. G. P. Lewis
Engine Company _____ Contractor _____

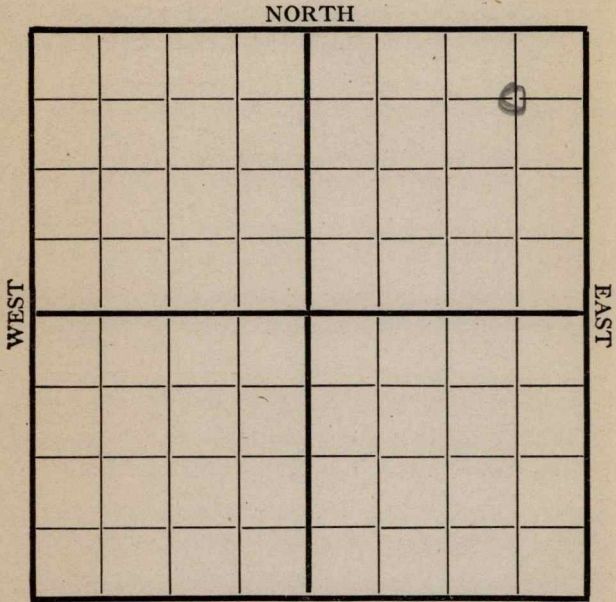

660748

Location _____

Rig up

Drilling and Remarks:

RECORD

Cased _____ in., _____ ft.

Sand _____

Gas _____

Oil _____

Total Depth _____

PRODUCTION

1st 24 hrs. Nat. _____

1st 24 hrs. after shot _____

Gas _____ Cu. Ft.

Dry Hole _____

Abandoned _____


Date 12/25 I. G. P. Lewis 1911 Scout

Map No. K10 Sec. 35 Twp. 27 R. 8

Well No. 15 P Lewis

Engine Company

Contractor

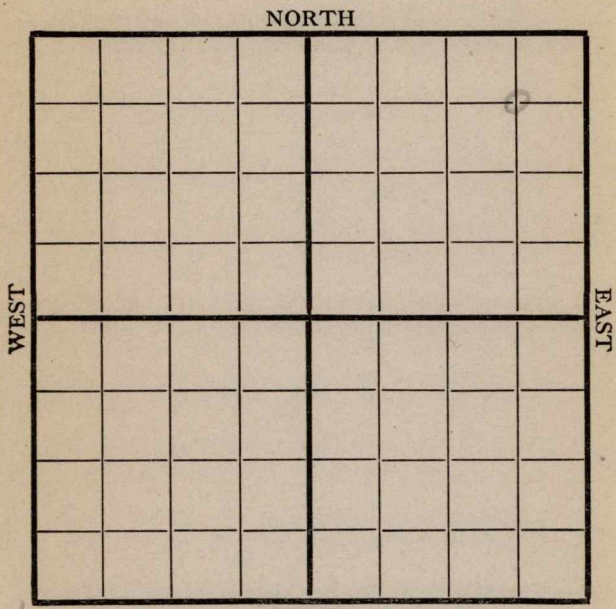

660542

Location _____

Rig up _____

Drilling and Remarks:

RECORD

Cased _____ in., _____ ft.

Sand _____

Gas _____

Oil _____

Total Depth _____

PRODUCTION

1st 24 hrs. Nat. _____

1st 24 hrs. after shot _____

Gas _____ Cu. Ft.

Dry Hole _____

Abandoned _____

Date

1/1 1919 9 Conroy Scout


Map No. K 10 Sec. 35 Twp. 27 R. 8

Well No. Lewis

Engine Company

Contractor

NORTH

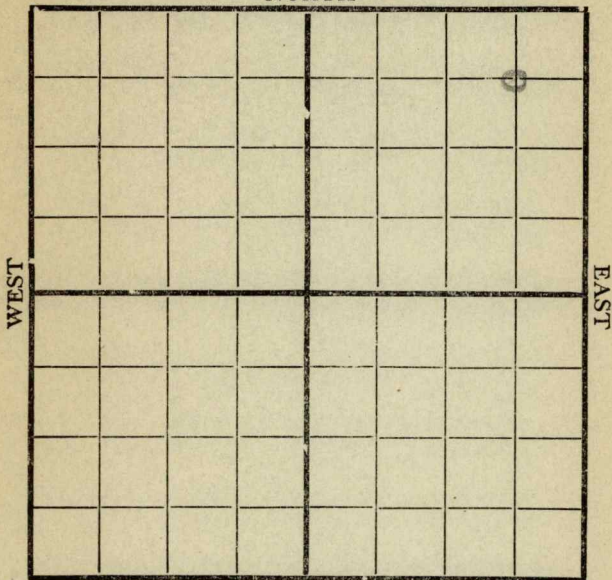

660472 SOUTH

Location _____

Rig up

Drilling and Remarks:

RECORD

Cased _____ in., _____ ft.

Sand _____

Gas _____

Oil _____

Total Depth _____

PRODUCTION

1st 24 hrs. Nat. _____

1st 24 hrs. after shot _____

Gas _____ Cu. Ft.

Dry Hole _____

Abandoned _____

Date

1/8


191

J. Conroy

Scout

Map No. 1510 Sec. 35 Twp. 27 R. 8

Well No. Lewis
Engine Company
Contractor

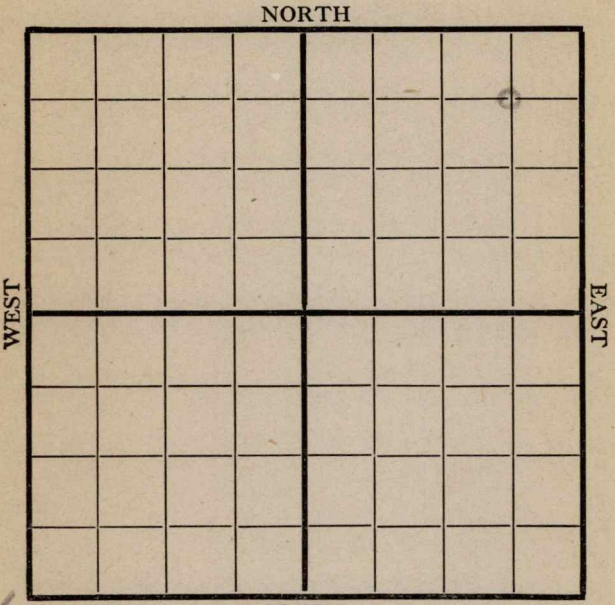

66047E SOUTH

Location _____
Rig up _____
Drilling and Remarks:

RECORD

Cased _____ in., _____ ft.
Sand _____
Gas _____
Oil _____
Total Depth _____

PRODUCTION

1st 24 hrs. Nat. _____
1st 24 hrs. after shot _____
Gas _____ Cu. Ft.
Dry Hole _____
Abandoned _____

Date 1/15 1919 9 Conroy Scout


Map No. K10 Sec. 35 Twp. 27 R. 8

Well No. 1, 2 R Lewis

E engine Company

Shutt Bros Contractor

Beaumont NORTH Kans

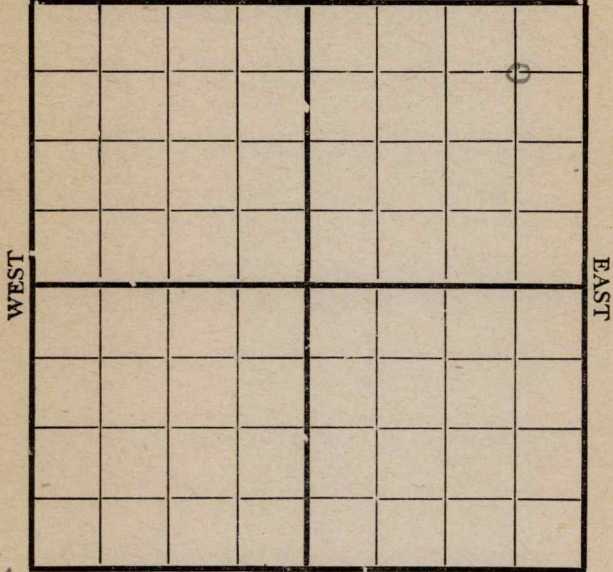

660 84 E SOUTH

Location

Rig up

Drilling and Remarks:

380

RECORD

Cased..... in., ft.

Sand

Gas

Oil

Total Depth.....

PRODUCTION

1st 24 hrs. Nat.

1st 24 hrs. after shot

Gas..... Cu. Ft.

Dry Hole.....

Abandoned.....

Date

1/22

1919


Carney

Scout

Map No. T 10 Sec. 35 Twp. 27 R. 8

Well No. 1 Lewis
Empire Company

Contractor

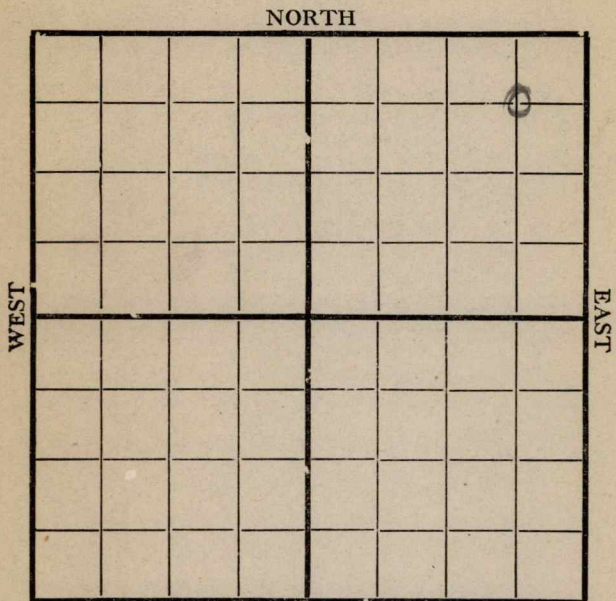

660 N-E SOUTH

Location

Rig up

Drilling and Remarks:

690'

RECORD

Cased.....in.,ft.
 Sand.....
 Gas.....
 Oil.....
 Total Depth.....

PRODUCTION

1st 24 hrs. Nat.....
 1st 24 hrs. after shot.....
 Gas.....Cu. Ft.
 Dry Hole.....
 Abandoned.....

Date Jan 29 1919

Pyle Scout

Map No. K10 Sec. 35 Twp. 27 R. 8

Well No. 1 Lewis


Empire Company

Contractor

NORTH

WEST

EAST

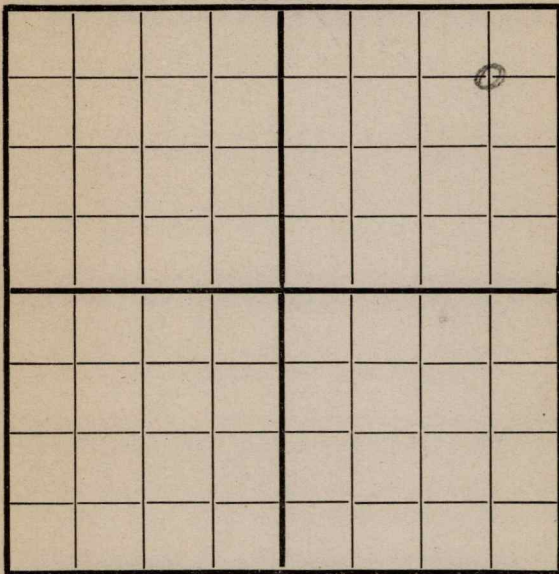

SOUTH

660 N-E

Location _____

Rig up _____

Drilling and Remarks:

940'

RECORD

Cased _____ in., _____ ft.

Sand _____

Gas _____

Oil _____

Total Depth _____

PRODUCTION

1st 24 hrs. Nat. _____

1st 24 hrs. after shot _____

Gas _____ Cu. Ft.

Dry Hole _____

Abandoned _____

Date

Pyle

2/9 1919

Scout

Map No. K10 Sec. 35 Twp. 27 R. 8


Well No. 1 Lewis
Empire Company

Contractor

NORTH

WEST

EAST

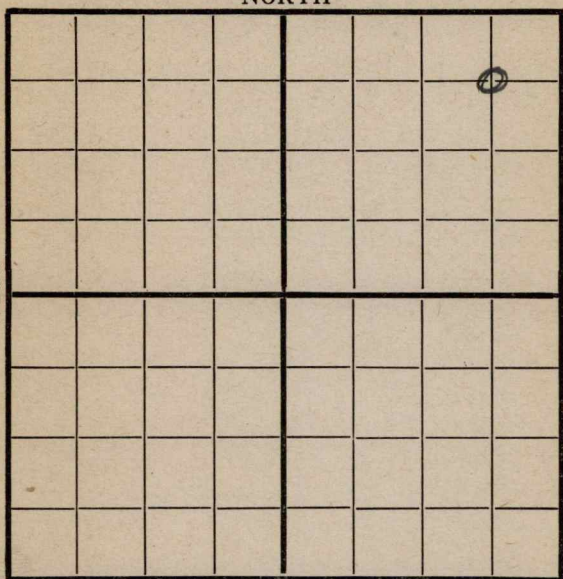

660 N-E SOUTH

Location _____

Rig up _____

Drilling and Remarks:

21 R 6 5/8
to 1140'

RECORD

Cased _____ in., _____ ft.

Sand _____

Gas _____

Oil _____

Total Depth _____

PRODUCTION

1st 24 hrs. Nat. _____

1st 24 hrs. after shot _____

Gas _____ Cu. Ft.

Dry Hole _____

Abandoned _____

Date

2/12 1919


Cyle Scout

Map No. K10 Sec. 35 Twp. 27 R. 8

Well No. 1 G. R. Lewis

Empire Company

Contractor

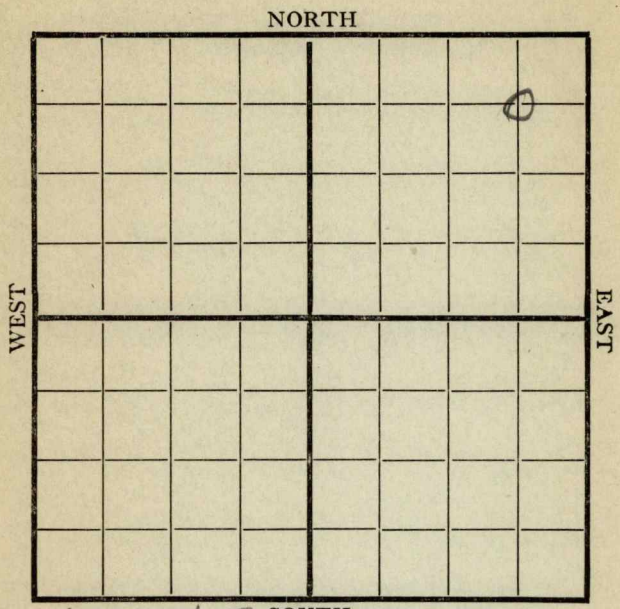

660 N-E SOUTH

Location _____

Rig up _____

Drilling and Remarks:

1176'

65 1/8" hole

RECORD

Cased _____ in., _____ ft.

Sand _____

Gas _____

Oil _____

Total Depth _____

PRODUCTION

1st 24 hrs. Nat. _____

1st 24 hrs. after shot _____

Gas _____ Cu. Ft.

Dry Hole _____

Abandoned _____

Date

2/21 1919

Pyle


Scout

Map No. K10 Sec. 35 Twp. 27 R. 8

Well No. 1 G. R. Lewis

Empire Company

Contractor

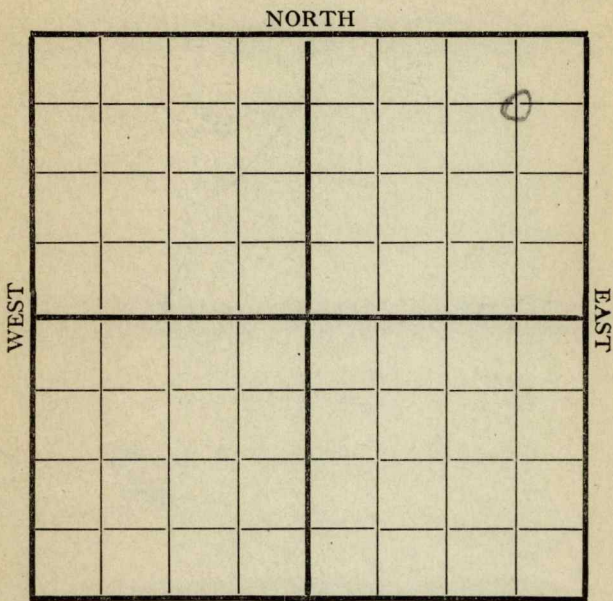

660 N-E

Location _____

Rig up _____

Drilling and Remarks:

NR 6 5/8 to
1176'

RECORD

Cased _____ in., _____ ft.

Sand _____

Gas _____

Oil _____

Total Depth _____

PRODUCTION

1st 24 hrs. Nat. _____

1st 24 hrs. after shot _____

Gas _____ Cu. Ft.

Dry Hole _____

Abandoned _____

Date

2/25 1919

Oyle Scout

Map No. K10 Sec. 35 Twp. 27^S R. 8^E


Well No. 1 Lewis

Empire

Company

Contractor

NORTH

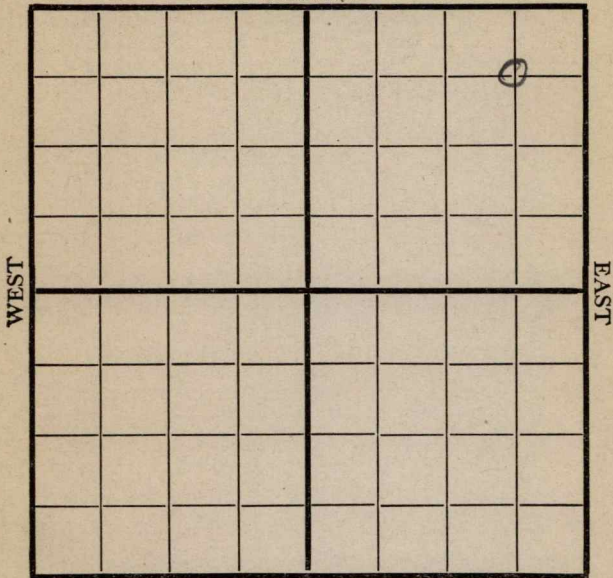

660 N-E SOUTH

Location -----

Rig up -----

Drilling and Remarks:

N. R. 6 5/8
To 1176

RECORD

Cased ----- in., ----- ft.

Sand -----

Gas -----

Oil -----

Total Depth -----

PRODUCTION

1st 24 hrs. Nat. -----

1st 24 hrs. after shot -----

Gas ----- Cu. Ft.

Dry Hole -----

Abandoned -----

Date

3/7

1919

Pyle


Scout

Map No. K10 Sec. 35 Twp. 27^S 8^E R.

Well No. 1 Lewis

Empire Company

Contractor

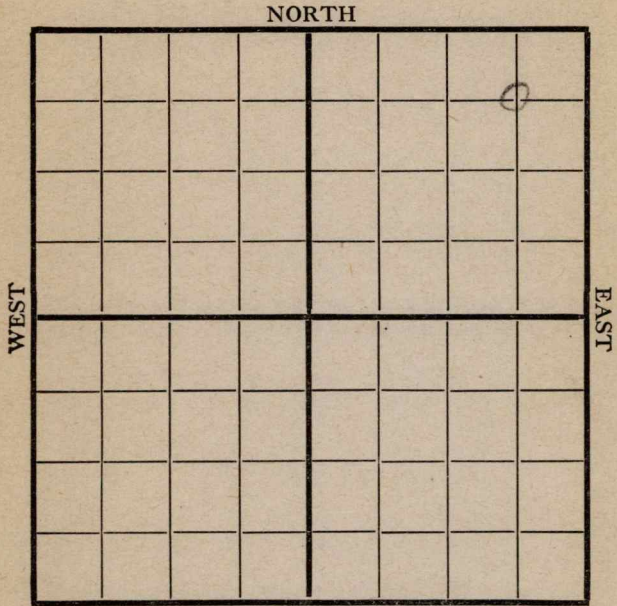

660 N-E

Location _____

Rig up _____

Drilling and Remarks:

D. H. for casing @ 1176'

RECORD

Cased _____ in., _____ ft.

Sand _____

Gas _____

Oil _____

Total Depth _____

PRODUCTION

1st 24 hrs. Nat. _____

1st 24 hrs. after shot _____

Gas _____ Cu. Ft.

Dry Hole _____

Abandoned _____


Date

3/12 1919 Pyle Scout

Map No. K10 Sec. 35 Twp. 27^S R. 8^E

Well No. 1 Lewis
Empire T. & F. Company

Contractor

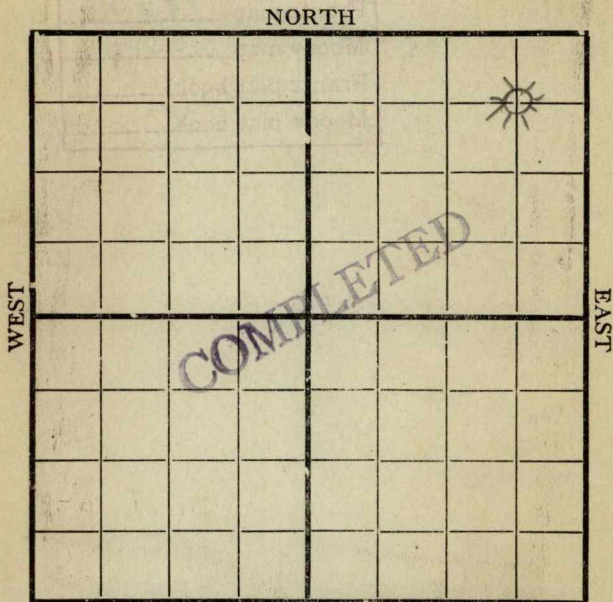

660 N-E

Location _____
Rig up _____
Drilling and Remarks:

RECORD

Cased _____ in., _____ ft.
Sand _____
Gas 1171 - 1176
Oil _____
Total Depth _____

PRODUCTION

1st 24 hrs. Nat. _____
1st 24 hrs. after shot _____
Gas 1/2 Million Cu. Ft.
Dry Hole _____
Abandoned _____

Date 3/18 1919 Pyle Scout