

Section 14 Township 13 Range 15W

Well No. #1 Brungardt

Company Shelly-Miller

NORTH

							0

WEST

EAST

SOUTH

Russell **KANSAS** ✓

Sec. 14 Twp. 13 R. 15W

Well No. #1 Brungardt Farm

Shelly - Miller Company

Shelly - Miller
Wildcat Contractor


330 Ft. from N. Line

Ft. from S. Line

330 Ft. from E. Line

Ft. from W. Line

NE NE SE
Texas - DHM

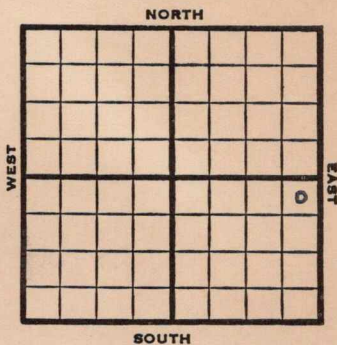

1952 Elev. 1811' REPORT

11/19 Spud 11-15-52
8" @ 155
Anhy 887'
Drlg. 1795'

11/27 Heeb 2934, Lans 2991
DST 3010-38 3/4 hrs., 15' M
Drlg. 3138'

12/3 Spud 11-15-52
D&A
TD 3278
8" @ 155
Anhy 887, Heeb. 2934, Lans 2991,
DST 3010-38, opn 3/4 hrs., rec.
15' mud, 105#
Cong 3251+, Arb. 3259
TD 3278
D&A

ABANDONED

County **Russell** State **KANSAS**

Sec. **14** (Blk.) **13** (Sur.) **15W** Map No.

Operator **Shelly - Miller**

Well No. **1** Farm **Brungardt**

Elev. Location **NE NE SE**

FIRST REPORT

330 Ft. From **N** Line **SE**

330 Ft. From **E** Line **Quarter**

1st. Report **NOV 19 1952**

Completion

Remarks **Texas - DHM**

Shelly - Miller - Contr.

Spudding Date **11-15-52**

Drig. Data **Wildcat**

8" @ 155 Anhy 887 drlg. 1795

County Russell State Kansas

Sec. 14 (Blk. 13 (Sur. 15W (Twp.) (Rge.) Map No.

Operator Shelly-Miller

Well No. 1 Farm Brungardt

Elev. 1811 Location NE NE SE



330 Ft. From N Line SE

330 Ft. From E Line Quarter

1st. Report

Completion DEC 3 1952

Remarks Wildcat

Shelly-Miller - Contr.

Spudding Date 11-15-52

Drlg. Data D & A TD 3278

8" @ 155 Anhy 887 Heeb. 2934

Lans. 2991 DST 3010-38 open 3/4 hr.

Rec. 15' mud 105# Cong. 3251

Arb. 3259 TD 3278

D & A

221 01 330