

Section 26 Township 27 Range 8-E

Well No. #1 Lewis "D"

Company Weideman

Miscellaneous

NORTH

							0

WEST

EAST

SOUTH

Sec. 26 Twp. 27 R. 8-E

Well No. #1 Lewis "D" Farm

Weideman Company


(Misc.)

330 Ft. from N. Line

\_\_\_\_\_ Ft. from S. Line

255 Ft. from E. Line

\_\_\_\_\_ Ft. from W. Line

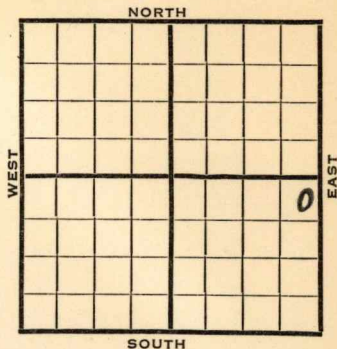

1940	REPORT
5/22	(75' East old abandoned well)
	Location
5/23	"
5/29	Drlg. 400'
6/6	Drlg. 440'
6/13	SD 855'
6/20	12" - 855' Drlg. 1020'
6/27	C.O. 1175'
7/3	10" - 1170' Drlg. 1475'
7/11	SD 1582'
7/18	K.C. 1736' 8" - 1852'
	Drlg. 2490'
7/25	Miss. 2495' 6" - 2500' T.D.
7/31	Miss. 2495'
	T.D. 2510'
	1000 acid.
	25 oil & 30 water.
	<b>COMPLETED</b>

Map No. 10 Sec. 26 Twp. 27 R. 8E

Well No. 1 Lewis "D"

Weideman

Company

Contractor

**FIRST REPORT**  
NE SE

**SECTION PLAT**

330 Ft. from N. Line

\_\_\_\_\_ Ft. from S. Line

255 Ft. from E. Line

\_\_\_\_\_ Ft. from W. Line

			o

Miscellaneous

Location X

Rig up \_\_\_\_\_

Drilling and Remarks:

75' East Old  
Abandoned Well

**RECORD**

Cased \_\_\_\_\_ in., \_\_\_\_\_ ft.

Sand \_\_\_\_\_

Gas \_\_\_\_\_

Oil \_\_\_\_\_

Total Depth \_\_\_\_\_

**PRODUCTION**

1st 24 hrs. Nat. \_\_\_\_\_

1st 24 hrs. after shot \_\_\_\_\_

Gas \_\_\_\_\_ Cu. Ft.

Dry Hole \_\_\_\_\_

Abandoned \_\_\_\_\_

Date

MAY 22 1940<sub>19</sub>

S. J. LEWIS Scout

Map No. 10 Sec. 26 Twp. 27 R. 8EWell No. 1 Lewis "D"Weideman

Company

Contractor

COMPLETED

NE SE

SECTION PLAT

330 Ft. from N. Line

			0

\_\_\_\_\_ Ft. from S. Line

255 Ft. from E. Line

\_\_\_\_\_ Ft. from W. Line

MISCELLANEOUS

Location \_\_\_\_\_

RECORD

Rig up \_\_\_\_\_

Cased \_\_\_\_\_ in., \_\_\_\_\_ ft.

Drilling and Remarks:

Saps Miss 24951000 acid

Gas \_\_\_\_\_

Oil \_\_\_\_\_

Total Depth 2510

PRODUCTION

1st 24 hrs. Nat. \_\_\_\_\_

1st 24 hrs. after shot \_\_\_\_\_

Gas \_\_\_\_\_ Cu. Ft.

Dry Hole \_\_\_\_\_

Abandoned \_\_\_\_\_

Date

JUL 31 1940

19

S. J. LEWIS

Scout