

Greenwood

KANSAS

26


27S

8E

SECTION \_\_\_\_\_ TOWNSHIP \_\_\_\_\_ RANGE \_\_\_\_\_

WELL NO. #8 Lewis "D"

COMPANY Beaumont

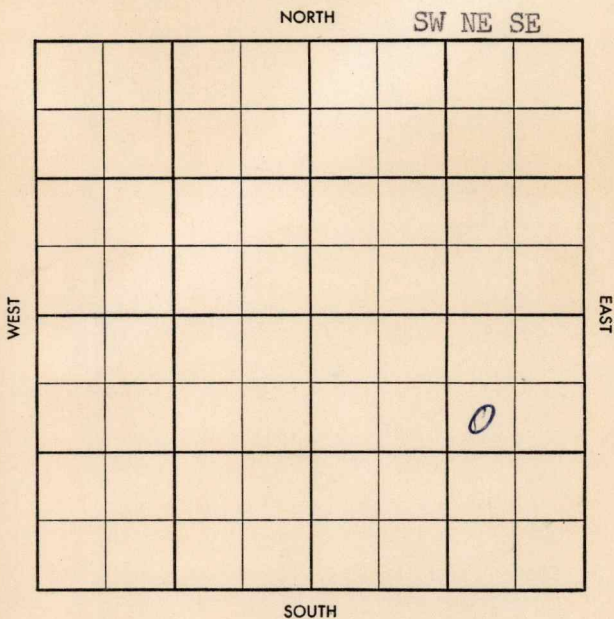

30

5-513-A

CO. ~~Greenwood~~ ELEV ~~1486~~  
SEC. ~~26~~ TWP. 27 RGE. 8E  
COMPANY Beaumont NO. 8

GF DEC 11 57  
**ABANDONED**

FARM Lewis "D"

LOC. SW NE SE


GEOL. \_\_\_\_\_  
CONTR. Co. Tools  
POOL Beaumont  
SPUD 11-26-57  
Location NOV 27 58 SEC 4 8E  
103461 #2475  
DEC 11 57 KC 1743  
BKC 1910  
Mann 2050  
Ce Sh 2230

M Li 2505 Cowley Li  
2523 RTD 2545 1

D & A

CO. NO. SEC. TWP. RGE.

CO. Greenwood ELEV. \_\_\_\_\_  
SEC. 26 TWP. 27 RGE. 8E  
COMPANY Beaumont NO. 8

FIRST REPORT  
NOV 20 1937

FARM Lewis "D"

LOC. SW NE SE


GEOL. \_\_\_\_\_  
CONTR. Co. Tools  
POOL Beaumont  
SPUD \_\_\_\_\_  
Location

CO.

LSE.

NO.

SEC.

TWP.

RGE.

~~36~~