


Map No. _____ Sec. 26 Twp. 27 R. 8
 Well No. 1. Temple Farm _____
Empire G. & F. Co. Company

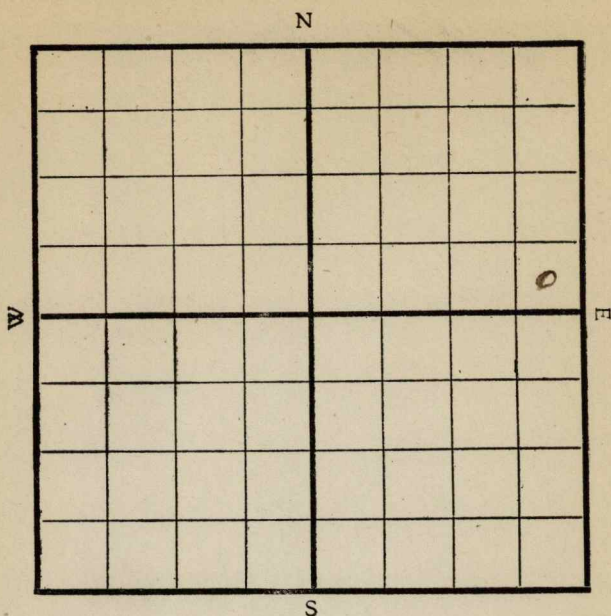

Location _____

Rig Up _____

Drilling Remarks:

Drilling Remarks:

COMPLETED

RECORD

Cased _____ in. _____ ft.

Sand _____

Gas _____

Oil _____

Total Depth _____

PRODUCTION

1st 24 hrs. Nat. _____

1st 24 hrs. after shot _____

Gas _____ cu. ft.

Dry Hole _____

Abandoned _____

Map No. 1 Sec. 26 Twp. 27 R. 8

Well No. 1. Temple Farm

Empire Dr. F. Co. Company

Contractor


ME Quarter

Ft. from N. Line

330 Ft. from S. Line

330 Ft. from E. Line

Ft. from W. Line

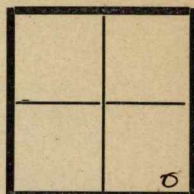

REPORT

10/19

10/29

Spudding.

11/22

Drill 1560'

12/11

Dr 1700'

2/1/20

Run 2500' - 36' - Dr Engine

4/27

Run 2500-36 - 10 ft per.

FIRST REPORT

COMPLETED

Map No. _____ Sec. 26 Twp. 27 R. 8Well No. 1 TempleEmpire Company_____
Contractor

SECTION PLAT

Ft. from N. Line330 Ft. from S. Line330 Ft. from E. Line_____
Ft. from W. Line

			8

FIRST REPORT

Location _____

Rig up _____

Drilling and Remarks:

Spud

RECORD

Cased _____ in., _____ ft.

Sand _____

Gas _____

Oil _____

Total Depth _____

PRODUCTION

1st 24 hrs. Nat. _____

1st 24 hrs. after shot _____

Gas _____ Cu. Ft.

Dry Hole _____

Abandoned _____

Date

Pyle

10/28 1919

Scout

Map No. K 10 Sec. 26 Twp. 27 R. 8

Well No. 1 Temple

Empire Company

Contractor

SECTION PLAT

			●

----- Ft. from N. Line

330 Ft. from S. Line

330 Ft. from E. Line

----- Ft. from W. Line

Location -----

Rig up -----

Drilling and Remarks:

RECORD

Cased ----- in., ----- ft.

Sand 2500-36

Gas -----

Oil -----

Total Depth -----

PRODUCTION

1st 24 hrs. Nat. 10 bbls

1st 24 hrs. after shot -----

Gas ----- Cu. Ft.

Dry Hole -----

Abandoned -----

Date

4/27 1920

Pyle

Scout