

KANSAS


Greenwood

FORM 51 5M 1-42 PETROL

Section 26 Township 27 Range 8-E

Well No. #3 Temple

Company K. T. Wiedemann

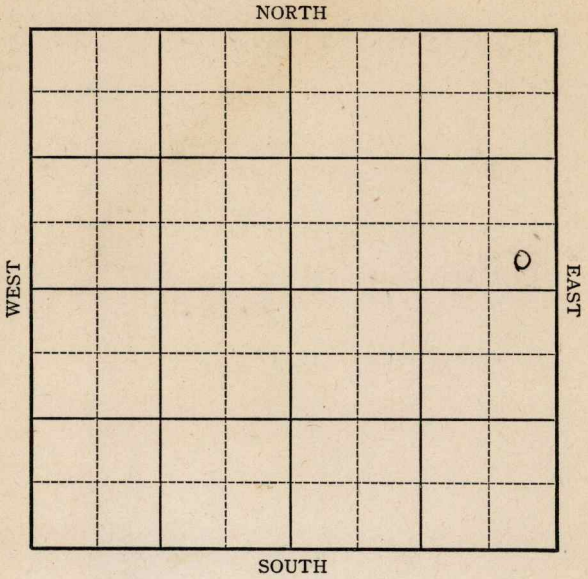

KANSAS

27 Greenwood

Sec. 26 Twp. 28 R. 8-E

Well No. #3 Temple Farm

K. T. Wiedemann Company

Miscellaneous

_____ Ft. from N. Line


300

~~330~~ Ft. from S. Line

300

~~330~~ Ft. from E. Line

_____ Ft. from W. Line

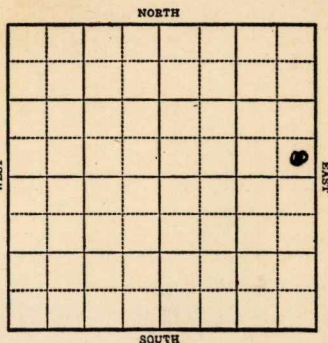

Twin to #1 Temple

1943

R E P O R T

5/12 Drlg. 825'

5/19 Drlg. 1015'

5/26 12" @ 890'
10" @ 1165
Drlg. 1600'

6/2 8" @ 1718

KC 1810

Drlg. 2280'

6/9 **Miss 2530-35 T.D. S.O.**

7" @ 2530 WOC.

6/16 " " "

6/23 **- Miss. 2533**

7" @ 2533'

T.D. 2538'

1000 gal acid

Pump 15 Pot.

Gravity 38

COMPLETED

KANSAS

Greenwood

Map No. 10 Sec. 26 Twp. 28 R. 8E

Well No. 3 Temple

K. T. Wiedemann Company

FIRST REPORT Contractor

SE NE

SECTION PLAT

Abandoned Location
Correction
to follow

Ft. from N. Line

330 Ft. from S. Line

330 Ft. from E. Line

Ft. from W. Line

MISCELLANEOUS

Location

Rig up

Drilling and Remarks:

Drlg. 825'

RECORD

Cased in, ft.

Sand

Gas

Oil

Total Depth

PRODUCTION

1st 24 hrs. Nat.

1st 24 hrs. after shot

Gas Cu. Ft.

Dry Hole

Abandoned

Date

MAY 12 1943

19

S. J. LEWIS

Scout

KANSAS

Greenwood

Map No. 10 Sec. 26 Twp. 27 R. 8E

Well No. 3 Temple

K. T. Wiedemann Company

CORRECTION Contractor

SE NE

SECTION PLAT

_____ Ft. from N. Line

330 Ft. from S. Line

330 Ft. from E. Line

_____ Ft. from W. Line

MISCELLANEOUS

Location _____

Rig up _____

Drilling and Remarks:

Reported

26-28-8E

RECORD

Cased _____ in., _____ ft.

Sand _____

Gas _____

Oil _____

Total Depth _____

PRODUCTION

1st 24 hrs. Nat. _____

1st 24 hrs. after shot _____

Gas _____ Cu. Ft.

Dry Hole _____

Abandoned _____

Date

MAY 1 9 1943 19

S. J. LEWIS Scout

Misc Small Maps
Cards
Tracing
France Map
Scarborough Map
Moody Map
Geological Dept.
Moody Flat Book

Handwritten signature/initials

Sandy is this an old well drilling deeper
 We show a completed well the exact feet
 measurements as this ticket. The well
 was drilled by Empire O. & G. #1 Temple
 SE SE NE of 26-27N-8E. Drilled in 1919
 Sand 2500-36 10 bbls. Please check and
 advise if Old well drilling deeper. Also
 the well number is #1. Advise

Sam

*on a new location with
 different feet measurements*

~~We show an old well with the exact feet
 measurements as this location.~~

5/31/18

Sara;-

This note is being drilled in
the old hole which had been
a sandblast. Don't know anything
about the old hole as this office
has no record of it.

Sandy

KANSAS

Greenwood

Map No. 10 Sec. 26 Twp. 27 R. 8E

Well No. 3 Temple

K. T. Wiedemann Company

CORRECTION Contractor

SE NE

SECTION PLAT

 Ft. from N. Line

300 Ft. from S. Line

300 Ft. from E. Line

 Ft. from W. Line

Trin #1 Temple
MISCELANEOUS 2536

RECORD

Location

Rig up

Drilling and Remarks:

Old well on this
lease has been
plugged

Cased in., ft.

Sand

Gas

Oil

Total Depth

PRODUCTION

1st 24 hrs. Nat.

1st 24 hrs. after shot

Gas Cu. Ft.

Dry Hole

Abandoned

Date

MAY 26 1943

19

S. J. LEWIS

Scout

Greenwood

KANSAS

Map No. 10 Sec. 26 Twp. 27 R. 8E

Well No. 3 Temple

K. T. Wiedemann Company

COMPLETED Contractor

SE NE

SECTION PLAT

_____ Ft. from N. Line

300 Ft. from S. Line

300 Ft. from E. Line

_____ Ft. from W. Line

			6

MISCELLANEOUS

Location _____

Rig up _____

Drilling and Remarks:

Mis 2533
7" @ 2533
1000 acid
Pump 15 P.D.
38° S

RECORD

Cased _____ in., _____ ft.

Sand _____

Gas _____

Oil _____

Total Depth 2538

PRODUCTION

1st 24 hrs. Nat. _____

1st 24 hrs. after shot _____

Gas _____ Cu. Ft.

Dry Hole _____

Abandoned _____

Date

JUN 23 1943 19

S. J. LEWIS Scout