
KANSAS
Form 51—5M—7-39—Palace

Russell

Section 17 Township 13 Range 15-W

Well No. #1 F. Schmidtberger

Company Webb & Wakefield

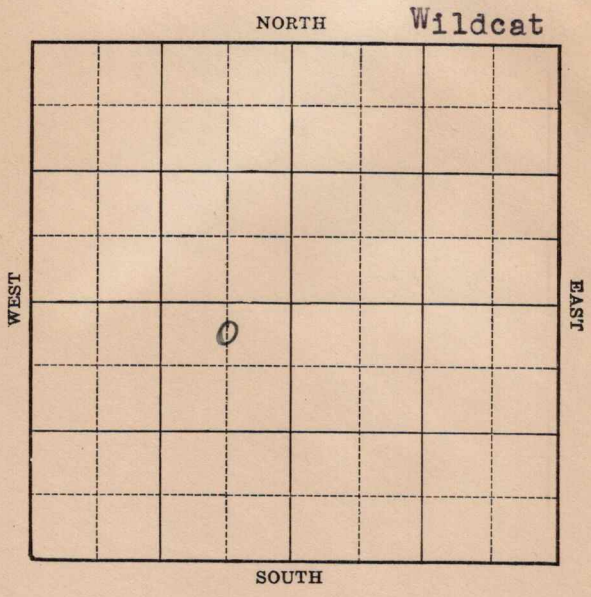

11

FORM 252-A 5M KANSAS Russell

Sec. 17 Twp. 13 R. 15-W

Well No. #1 F. Schmidtberger Farm

Webb & Wakefield Company


(Wildcat)

330 Ft. from N. Line

Ft. from S. Line

660 Ft. from E. Line

Ft. from W. Line

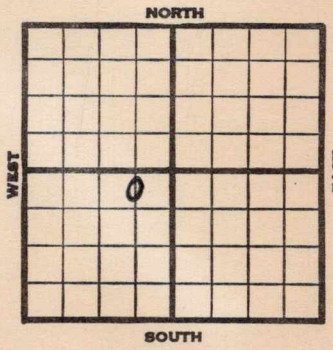

Elev. 1877

1939	REPORT
12/20	Mat'l. Cable.
12/28	" "
1940	
1/4	Rigging up.
1/11	" "
1/18	Spud.
1/25	15" - 310' 12½" - 520'
	Drlg. 760'
2/1	Anhy 940' Drlg. 1780'
2/8	Drlg. 2493'
2/15	8" - 2325' Lans. ~~3048~~ 3044'
	6" - 3050' Drlg. 3066'
2/23	Lans. 3044' (Corrected)
	6" - 3089' Arb. 3308'-12 T.D.
	C.O.
2/28	Arb. 3308' water.
	T.D. 3353'
	ABANDONED

Form 26—1M Bks.—2-29 Russell KANSAS

Map No. 72 Sec. 17 Twp. 13 R. 15W

Well No. 1 F.Schmidtberger

Webb & Wakefield Company

Contractor

FIRST REPORT

C N L NE SW

330 Ft. from N. Line


Ft. from S. Line

660 Ft. from E. Line

Ft. from W. Line

WILDCAT

SECTION PLAT

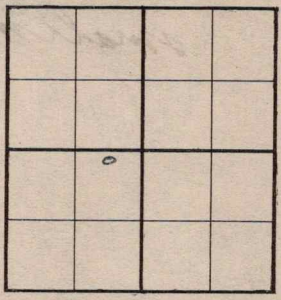

Location

Rig up

Drilling and Remarks:

Matl. Cable

RECORD

Cased in., ft.

Sand

Gas

Oil

Total Depth

PRODUCTION

1st 24 hrs. Nat.

1st 24 hrs. after shot

Gas Cu. Ft.

Dry Hole

Abandoned

Date

DEC 20 1939

19 S. J. LEWIS Scout

Form 26—1M Bks.—2-29 Russell KANSAS

Map No. 72 Sec. 17 Twp. 13 R. 15W

Well No. 1 F. Schmidtberger

Webb & Wakefield Company

Contractor

ABANDONED

C N L NE SW

330 Ft. from N. Line


Ft. from S. Line

660 Ft. from E. Line

Ft. from W. Line

WILDCAT

SECTION PLAT

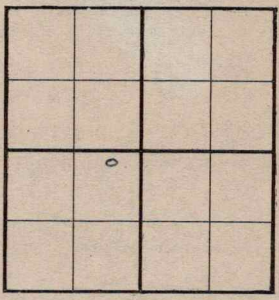

Location

Rig up

Drilling and Remarks:

Cu @ 3308.

Water.

RECORD

Cased in., ft.

Sand

Gas

Oil

Total Depth 3353

PRODUCTION

1st 24 hrs. Nat.

1st 24 hrs. after shot

Gas Cu. Ft.

Dry Hole

Abandoned

Date

FEB 28 1940 19 S. J. LEWIS Scout