

Section 14 Township 27 Range 9EWell No. 1 AmerineCompany K.T. Weidemann

Misc.

NORTH

WEST

EAST

							0

SOUTH

KANSAS

Greenwood



Sec. 14 Twp. 27 R. 9E

Well No. #1 Amerine Farm

K. T. Weidemann Company

Miscellaneous


330' Ft. from N. Line

 Ft. from S. Line

330' Ft. from E. Line

 Ft. from W. Line

NE/C

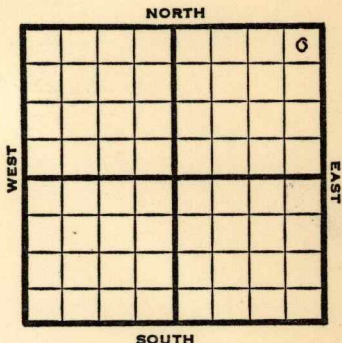

1948

REPORT

12/15	Spud Twin to dry hole 200 X 200
12/22	Drlg. 830'
12/29	"
1/5	Drlg. 1550'
1/12	1550' SD
1/19	12" @ 880' 10" @ 1672' Drlg. 1840'
1/26	1875 sd
2/2	"
2/9	8" @ 2200' CO
2/16	"
2/23	"
3/2	"
3/9	TD 2630' Arb. 2582' Aband.

ABANDONED

Map No. _____ Sec. 14 Twp. 27 R. 9E

Well No. 1 Amerine

K. T. Weidemann Company

FIRST REPORT Contractor

NE/C


SECTION PLAT

330 Ft. from N. Line

_____ Ft. from S. Line

330 Ft. from E. Line

_____ Ft. from W. Line

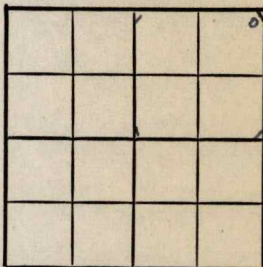

Greenwood County

Location _____

Rig up _____

Drilling and Remarks:

spud

twin to dry hole

200 X 200

RECORD

Cased _____ in., _____ ft.

Sand _____

Gas _____

Oil _____

Total Depth _____

PRODUCTION

1st 24 hrs. Nat. _____

1st 24 hrs. after shot _____

Gas _____ Cu. Ft.

Dry Hole _____

Abandoned _____

Date

DEC 15 1948

19

S. J. LEWIS

Scout

Kansas

Map No. K10 Sec. 14 Twp. 27 R. 9EWell No. 1 AmerineK. T. Weidemann

Company

ABANDONED

Contractor

NE/C

SECTION PLAT

330

Ft. from N. Line

Ft. from S. Line

330

Ft. from E. Line

Ft. from W. Line

			0

Greenwood County

Location

Rig up

Drilling and Remarks:

Cor 82582

RECORD

Cased _____ in., _____ ft.

Sand _____

Gas _____

Oil _____

Total Depth 2630

PRODUCTION

1st 24 hrs. Nat. _____

1st 24 hrs. after shot _____

Gas _____ Cu. Ft.

Dry Hole _____

Abandoned _____

Date

MAR 9 1949 19S. J. LEWIS

Scout