Russell


KANSAS

SECTION 18 TOWNSHIP 13 RANGE 15W

WELL NO. #1 Nowak

COMPANY R.P. Nixon

NORTH SE SE SW

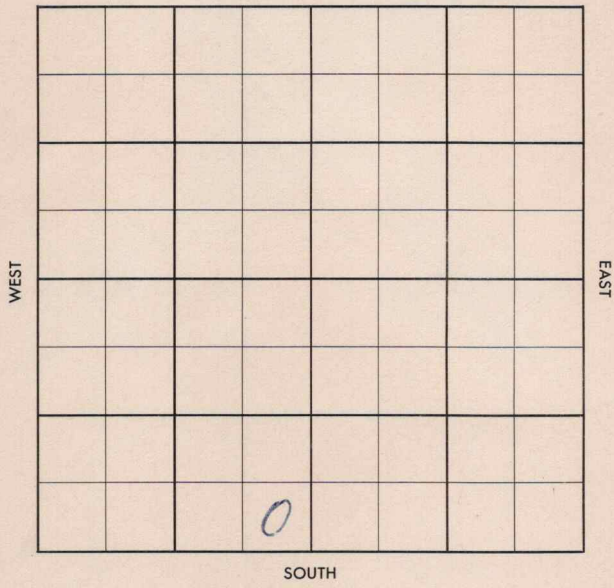

FORM 504-3 SUNRAY

WILDCAT

FORM 513 SUNRAY

County Russell Elev.

Sec. 18 Twp. 13 Rge. 15W

Company R. P. Nixon

Farm Name Nowak No. 1

TOPS	DEPTH	LOG	DATUM
Anh.			
T.P.			
H.			
Tr.			
Dg.			
B.L.			
L.			
K.C.			
B.K.C.			
Ce.			
C.			
M.			
M.			
K.			
Mz.			
Mq.			
V.			
S.			
S.			
A			
R.			
P€.			
G.			
T.D.			

Loc. in Sec. SE SE SW

Geol.

Contr. Wentworth Tools

Pool Wildcat



Date Comm. 6-27-57

Location

13

Co. Lease No. Sec. T. R.

FORM 513 SUNRAY

County Russell Elev. 1920

Sec. 18 Twp. 13 Rge. 15W

Company R. P. Nixon

Farm Name Nowak No. 1

TOPS	DEPTH	LOG	DATUM
Anh.			
Tp.	2840		
H.	3062		
Tr.	3081		
Dg.			
B.L.			
L.	3111		
K.C.			
B.K.C.			
Ce.			
C.			
M.			
M.			
K.			
Mz.			
Mo.			
V.			
S.			
S.			
A	3377		
R.			
P€.			
G.			
T.D.	3400		

Loc. in Sec. SE SE SW

Geol.

Contr. Wentworth Tool

Pool Wildcat

ABANDONED

JUL 17 '57

O

Date Comm. 6-27-57

Location JUL 3 57 6-30-57 ~~8-7-8~~

~~Q~~ D 1750 JUL 10 57 8-7-8 310

D 3180 JUL 17 57

D & A