

Section 20 Township 13 Range 15W

Well No. 1 Mermis

Company A. F. Schmidt

NORTH

WEST

EAST

SOUTH

16

6

Russell

KANSAS

SEC. 20	TWP. 13S	R. 15W
------------	-------------	-----------

WELL NO.
#1 Mermis


COMPANY
A. F. Schmidt

FARM

CONTRACTOR
Mast Drlf.

W.C.

_____ Ft. from N. Line
 _____ Ft. from S. Line
 _____ Ft. from E. Line
 _____ Ft. from W. Line

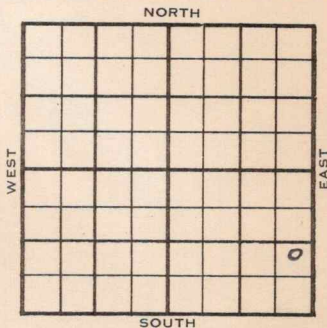

NE SE SE

FIRST REPORT

	ELEVATION	REPORT
1955	1895 DF	
7/13	Spud: 7/3/55 8" @ 200'	D3134
7/27	DST 3143-60 open 1 hr. Rec 190' vso & gcmw 675/20" DST 3159-71 open 1 hr. Rec 57' sw 760/20" DST 3319-31 open 1 hr. Rec. 2' mud Ø D&A	
	anh.	948
	H.	3019 1124
	L.	3070 1175
	A.	3324 1429
	TD	3360

ABANDONED

County Russell Elev. 1895 DF
 Sec. 20 Twp. 133 Rge. 15W
 Company A. F. Schmidt
 Farm Name Mermis No. 1

TOPS	DEPTH	LOG	DATUM
Anh.			
Tp.			
H.			
Tr.			
Dg.			
Bl.			
L.			
K.C.			
B.K.C.			
Ce.			
C.			
M.			
M.			
K.			
Mz.			
Me.			
V.			
S.			
S.			
A.			
R.			
Pe.			
G.			
T.D.			

Loc. in Sec. NE SE SE
 Geol. Nixon
 Contr. Mast Drlf.
 Pool W.C.

JUL 13 1955
 FIRST REPORT
 0

Date Comm. spd 7/3/55 8" 200' D3134

~~18~~

Co.
 Lse.
 No.
 Sec.
 T.
 R.

County Russell Elev. 1895
 Sec. 20 Twp. 13 Rge. 15W
 Company A. F. Schmidt
 FarmName Mermis No. 1

TOPS	DEPTH	LOG	DATUM	Loc. in Sec.
Anh.	<u>948</u>			NE SE SE
TP.				
H.	<u>3019</u>		<u>1124</u>	
Tr.				
Dg.				
Bl.				
L.	<u>3070</u>		<u>1175</u>	Geol.
K.C.				Contr.
B.K.C.				Mast Drlg.
Ce.				Pool
C.				Wildcat
M.				
M.				
K.				
Mz.				
Mq.				
V.				
S.				
S.				
A.	<u>3324</u>		<u>1429</u>	
R.				
PE.				
G.				
T.D.	<u>3360</u>			

Date Comm. 7-3-55 JUL 27 1955

8" @ 200 DST 3143-60 open 1 hr.
 Rec. 190' vso & gcmw 675/20"
 DST 3159-71 open 1 hr. Rec. 57' sw
 760/20" DST 3319-31 open 1 hr.
 Rec. 2' mud O#
 D & A

Co.
Lse.
No.
Sec.
T.
R.