


Russell

Map No. TRANS Sec. 20 Twp. 13 R. 15-W

Well No. 1 Sloan Farm

Keys Pet co Company

NORTH

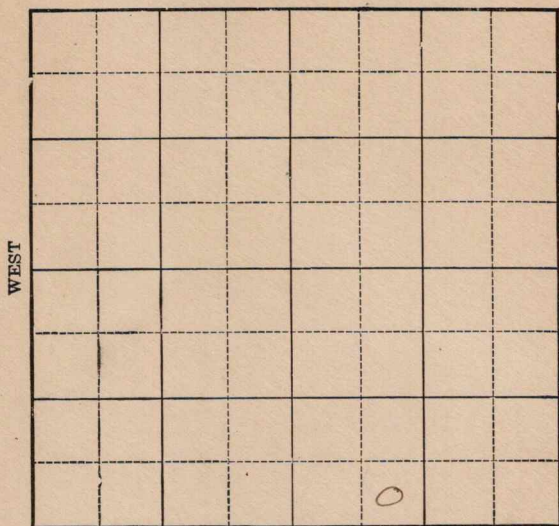

Location \_\_\_\_\_

Drilling Remarks

Rig Up \_\_\_\_\_

Drilling Remarks

RECORD

Cased \_\_\_\_\_ in. \_\_\_\_\_ ft.

Sand \_\_\_\_\_

Gas \_\_\_\_\_

Oil \_\_\_\_\_

Total Depth \_\_\_\_\_

PRODUCTION

1st 24 hrs. Nat. \_\_\_\_\_

1st 24 hrs. after shot \_\_\_\_\_

Gas \_\_\_\_\_ cu. ft.

Dry Hole \_\_\_\_\_

Abandoned \_\_\_\_\_

Russell Co

Map No. Kansas Sec. 20 Twp. 13 R 15<sup>W</sup>

Well No. 1 Sloan Farm


Keys Del Company

\_\_\_\_\_ Ft. from N. Line

300 Ft. from S. Line

\_\_\_\_\_ Ft. from E. Line

1070 Ft. from W. Line

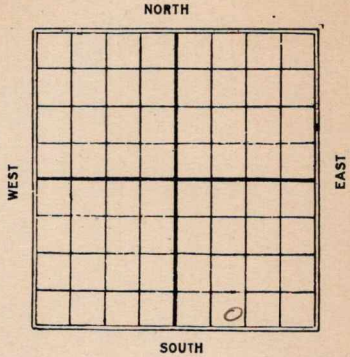

| Date  | REPORT   |
|-------|--|
| 7/26  |  |
| 7/9   | Spudded & S.D.   |
| 7/21  | —  |
| 8/11  | —  |
| 8/18  | —  |
| 8/25  | Dlg 400  |
| 8/31  | " 700  |
| 9/8   | " 1000   |
| 9/15  | " 1323   |
| 9/22  | T.D. 1323 fag tools  |
| 9/29  | Drlg 1413  |
| 10/6  | " 1727   |
| 10/13 | " 2470   |
| 10/20 | " 2550   |
| 10/27 | T.D. 2550 fighting cave  |
| 11/3  | Drlg 2650  |
| 11/10 | " 2775   |
| 11/17 | " 2820   |
| 11/24 | " 2950   |
| 12/11 | Top sand 3090<br>Drlg 3130   |
| 12/18 | Top sand 3091 show oil + gas 3170-72<br>3125 - 1/2 bailers water T.D. 3180'<br>u.R. 5" |

12/15 - T.D. 3180' S.D. 735916

12/21 - Drly 3365 fighting cave

12/29 - same

1927

1/5 - Sand 3080-3128

T.D. 3400

S. + Q. 3400'



Map No. **KANSAS** Sec. 20 Twp. 13 R. 15W

Well No. 1 Sloan

Keys P & S Company

Contractor

**SECTION PLAT**

----- Ft. from N. Line

300 Ft. from S. Line

----- Ft. from E. Line

1070 Ft. from W. Line

|  |  |  |  |
|--|--|--|--|
|  |  |  |  |
|  |  |  |  |
|  |  |  |  |
|  |  |  |  |

**FIRST REPORTS**

Location -----

Rig up -----

Drilling and Remarks:

Spud 8 1/2

**RECORD**

Cased ----- in., ----- ft.

Sand -----

Gas -----

Oil -----

Total Depth -----

**PRODUCTION**

1st 24 hrs. Nat. -----

1st 24 hrs. after shot -----

Gas ----- Cu. Ft.

Dry Hole -----

Abandoned -----

Date

JUL 14 1926

S. J. LEWIS

Scout

Map No. *Russell* **KANSAS** Sec. *20* Twp. *13* R. *15W*

Well No. *1 Sloan*

*Keys Pet* Company

Contractor

SECTION PLAT

----- Ft. from N. Line

*300* Ft. from S. Line

----- Ft. from E. Line

*1070* Ft. from W. Line

**ABANDONED**

|  |  |  |  |
|--|--|--|--|
|  |  |  |  |
|  |  |  |  |
|  |  |  |  |
|  |  |  |  |

Location -----

Rig up -----

Drilling and Remarks:

*Oswald sand  
3080 & 3128*

*3400 TII*

*IIIA.*

RECORD

Cased ----- in., ----- ft.

Sand -----

Gas -----

Oil -----

Total Depth -----

PRODUCTION

1st 24 hrs. Nat. -----

1st 24 hrs. after shot -----

Gas ----- Cu. Ft.

Dry Hole -----

Abandoned -----

Date

*JAN 5 1927*

**S. J. LEWIS**

Scout