



**KANSAS**

Russell

Sec. 19 Twp. 13 R. 15W ✓

Well No. #1 Poleyn Farm \_\_\_\_\_

B & R Drlg. Company \_\_\_\_\_

Wildcat

\_\_\_\_\_ Ft. from N. Line

**330'**


\_\_\_\_\_ Ft. from S. Line

**330'**

\_\_\_\_\_ Ft. from E. Line

\_\_\_\_\_ Ft. from W. Line

**SE SW**

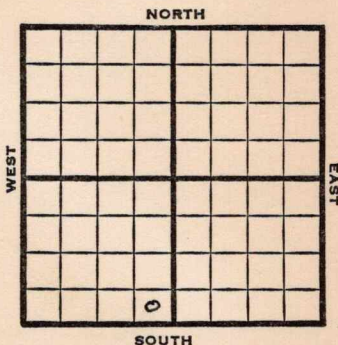

1949

**Elev 1931'**

REPORT

4/27

8" @ 217'

Drlg. 645'

5/4

Drlg 2888'

5/11

TD 3400'

**Lans. 3102'**

**rb. 3370'**

Aband.

**ABANDONED**

Kansas

Map No. \_\_\_\_\_ Sec. 19 Twp. 13 R. 15W

Well No. 1 Poleyn

B & R Drlg. \_\_\_\_\_ Company

FIRST REPORT

Contractor

SE SW

SECTION PLAT

\_\_\_\_\_ Ft. from N. Line

330 Ft. from S. Line

330 Ft. from E. Line

\_\_\_\_\_ Ft. from W. Line


Russell County

Location \_\_\_\_\_

Rig up \_\_\_\_\_

Drilling and Remarks:

8" @ 217

drlg. 645

RECORD

Cased \_\_\_\_\_ in., \_\_\_\_\_ ft.

Sand \_\_\_\_\_

Gas \_\_\_\_\_

Oil \_\_\_\_\_

Total Depth \_\_\_\_\_

PRODUCTION

1st 24 hrs. Nat. \_\_\_\_\_

1st 24 hrs. after shot \_\_\_\_\_

Gas \_\_\_\_\_ Cu. Ft.

Dry Hole \_\_\_\_\_

Abandoned \_\_\_\_\_

Date

APR 27 1949 19

S. J. LEWIS

Scout

