
KANSAS

FORM 51 5M 4-41 PETROL Russell

Section 20 Township 13 Range 15W

Well No. 1 Gernon

Company Derby Oil et al

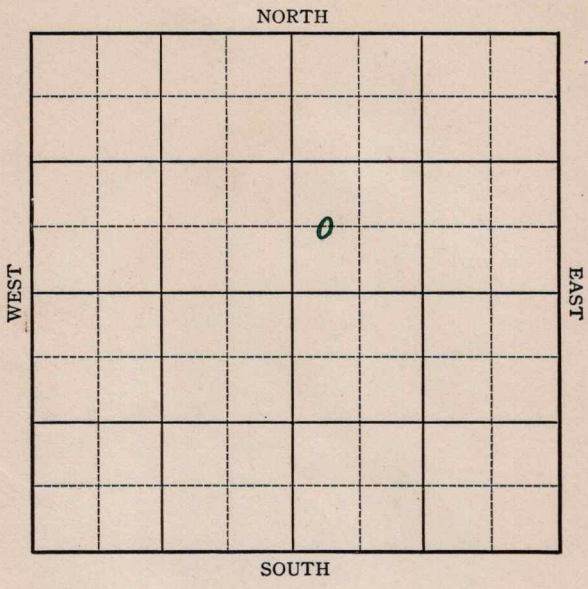

7

FORM 252-A 5M 1-41 PETROL KANSAS Russell

Sec. 20 Twp. 13 R. 15-W

Well No. #1 Gernon Farm

Derby Oil et al Company


(Wildcat)

____ Ft. from N. Line

660 Ft. from S. Line

____ Ft. from E. Line

330 Ft. from W. Line

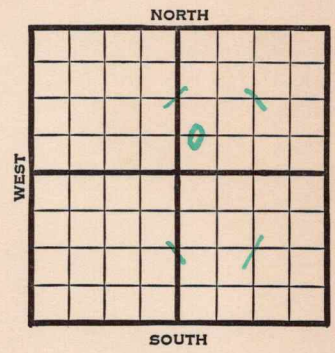

Elev. 1864

1941	REPORT
6/4	Location
6/12	Anhy. 965' 10" - 965'
	Drlg. 2175'
6/19	Topeka 2765' Lans. 3030'
	S. O. 3084-89' Arb. 3209'
	T.D. 3308' S.W.
6/25	Arb. 3290'
	T.D. 3311'
	Water.
	ABANDONED

Form 26—200 Bks.—1-40—Palace Russell KANSAS

Map No. 72 Sec. 20 Twp. 13 R. 15W

Well No. 1 Gernon

Derby Oil etal Company

Contractor

FIRST REPORT

C W L SW NE

Ft. from N. Line


660 Ft. from S. Line

Ft. from E. Line

330 Ft. from W. Line

WILDCAT

SECTION PLAT

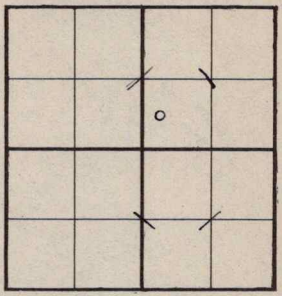

Location X

Rig up

Drilling and Remarks:

RECORD

Cased in., ft.

Sand

Gas

Oil

Total Depth

PRODUCTION

1st 24 hrs. Nat.

1st 24 hrs. after shot

Gas Cu. Ft.

Dry Hole

Abandoned

Date

JUN 4 1941 19

S. J. LEWIS Scout

Form 26 200 Bks. 5-41 McW. Russell KANSAS

Map No. _____ Sec. 20 Twp. 13 R. 15W

Well No. 1 Gernon

Derby etal Company

Contractor

ABANDONED

C W L SW NE

_____ Ft. from N. Line


660 Ft. from S. Line

_____ Ft. from E. Line

330 Ft. from W. Line

WILDCAT

SECTION PLAT

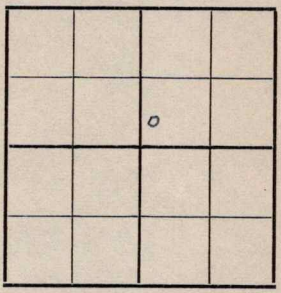

Location _____

Rig up _____

Drilling and Remarks:

Cu ✗ 3290

Water

RECORD

Cased _____ in., _____ ft.

Sand _____

Gas _____

Oil _____

Total Depth 3311

PRODUCTION

1st 24 hrs. Nat. _____

1st 24 hrs. after shot _____

Gas _____ Cu. Ft.

Dry Hole _____

Abandoned _____

Date

JUN 25 1941 19

S. J. LEWIS Scout