Russell


KANSAS

SECTION 20 TOWNSHIP 13S RANGE 15W

WELL NO. #1 Mermis

COMPANY A. F. Schmidt

NORTH NW NE NE

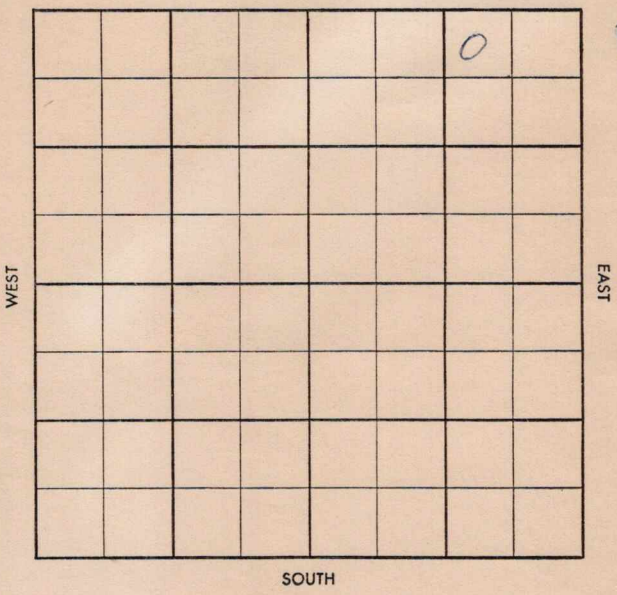

FORM 504-3 SUNRAY

Twp. X Pool X

Sec. X Pool

WILDCAT

S-513-B

County Russell Elev.

Sec. 20 Twp. 13 Rge. 15W

Company A. F. Schmidt

Farm Name Mermis No. 1

TOPS	DEPTH	LOG	DATUM
Anh.	887		
Tp.			
H.			
Tr.			
Dg.			
B. L.			
L.			
K.C.			
B.K.C.			
Ce.			
C.			
M.			
M.			
K.			
Mz.			
Mq.			
V.			
S.			
S.			
A.			
R.			
Pf.			
G.			
T.D.			

Loc. in Sec. NW NE NE

Geol. D. Vaughan

Contr. Triangle #1

Pool Wildcat

JUN 3 58 REPORT

FILE

Date Comm. 5/31/58

8" @ 212 w/130, Drlg. 1020

Co. Lse. No. Sec. T. R.

Twp. Pool

Co. Feet

S-513-B

County Russell Elev. 1832DF 1835 KB

Sec. 20 Twp. 13 Rge. 15W

Company A. F. Schmidt

Farm Name Mermis No. 1

TOPS	DEPTH	LOG	DATUM
Anh.	887		
Tp.			
H.	2947		
Tr.			
Dg.			
B. L.			
L.	2995		
K.C.			
B.K.C.			
Ce.			
C.			
M.			
M.			
K.			
Mz.			
Mq.			
V.			
S.			
S.			
A.	3258		
R.			
Pf.			
G.			
T.D.	3259		

Loc. in Sec. NW NE NE

Geol. D. Vaughan

Contr. Triangle #1

Pool KUNE

~~Wildcat~~

COMPLETE

JUL 23 '58

Date Comm. 5/31/58

8" @ 212 w/130, Drlg. 1020 JUN 11 '58 DST 2978 -3010 1hr 200' gip 40 50 Bgem BHP 125/20" DST 3007-30 1hr 780' gip 60' OBgcm 60' GCO 125 oil 55' SW BHP 850/20" DST 3044 -80 1hr 240' HO&gcm 180' HO&gcw BHP 870/20" JUN 18 '58 DST 3083 90 30" 5' OBgcw 85' SW BHP 855/15 DST 3156-85 1hr 75' gip 105' OCM

FORM 513-1 SUNRAY

60' 140 CM BHP 167/20" no log
5" 3259 w o c t JUN 25 '58 24/3188-92
3½ & 5 BOph 4 hrs NW B+P
3120 18/3085-88 3½ JUL 2 '58
JUL 9 '58 JUL 15 '58 ~~on pump~~ JUL 23 '58 &
5 BOph NW 4 hrs PB 3050
24/3031-35 3500 A & 10 BOph
NW 8 hrs CO 3200 POP ~~on~~
P 100 BOpd NW

P 25 BOpd NW

L 3031 - 3192

20 - 13 - 15 W nw ne