


Map No. 1 Sec. 22 Twp. 27 R. 9Well No. 1 - Lilley FarmSuperior oil Company

NORTH

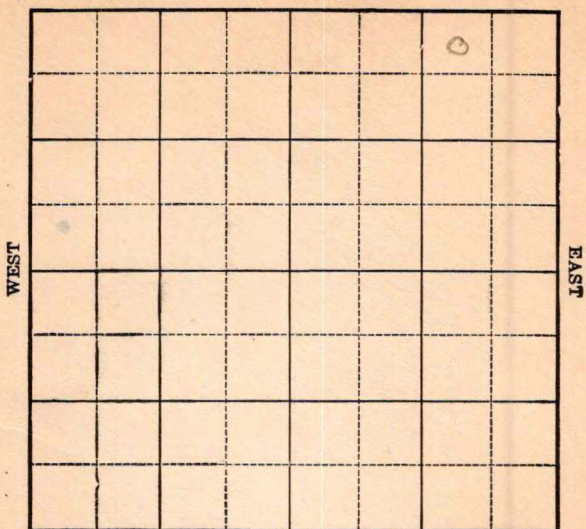

SOUTH

Location _____

Drilling Remarks _____

Rig Up _____

Drilling Remarks _____

RECORD

Cased _____ in. _____ ft.

Sand _____

Gas _____

Oil _____

Total Depth _____

PRODUCTION

1st 24 hrs. Nat. _____

1st 24 hrs. after shot _____

Gas _____ cu. ft.

Dry Hole _____

Abandoned _____


Map No. _____ Sec. 22 Twp. 27 R. 9
 Well No. 1 - Lilley Farm _____
Superior Oil Company _____

330 Ft. from N. Line

_____ Ft. from S. Line

990 Ft. from E. Line

_____ Ft. from W. Line

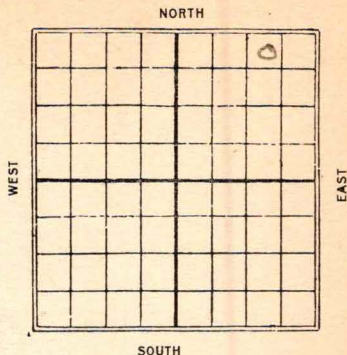

1927

Date

REPORT

3/1 T.O.G.
3/9 Rigging up
3/16 Rigged up + S.D.
3/24 Spudding
3/30 Drlg 720
4/7 " 1050
4/13 S.D. 1120
4/20 _____
4/27 Sand 2012-2015 Show oil
 Drilling 2140
5/5 Sand 2012-2015
 show oil
 Top line 2243
 H.F.W. 2293
 S.x.A. 2293

Greenwood
 10 **KANSAS** 22
 Map No. _____ Sec. _____ Twp. 27 R. 9
 Well No. 1 *Hilley*
Superior Oil Co Company

Contractor _____

FIRST REPORTS**SECTION PLAT**

330 _____ Ft. from N. Line

_____ Ft. from S. Line

990 _____ Ft. from E. Line

_____ Ft. from W. Line

			0

Location _____

Rig up _____

Drilling and Remarks:

RECORD

Cased _____ in., _____ ft.

Sand _____

Gas _____

Oil _____

Total Depth _____

PRODUCTION

1st 24 hrs. Nat. _____

1st 24 hrs. after shot _____

Gas _____ Cu. Ft.

Dry Hole _____

Abandoned _____

Date

MAR 2 1927

CHAS. L. SHERWOOD

192

Scout

10 **KANSAS** Sec. 22 Twp. 27 R. 9
 Map No. _____
 Well No. 1 Lilley _____

Superior Oil Co. _____ Company

_____ Contractor

COMPLETED

SECTION PLAT

330 _____ Ft. from N. Line

_____ Ft. from S. Line

990 _____ Ft. from E. Line

_____ Ft. from W. Line

ABANDONED

			0

Location _____

Rig up _____

Drilling and Remarks:

Done 2012-2015 New Oil

Top line 2243

AFW 2293

Oil 2293

RECORD

Cased _____ in., _____ ft.

Sand _____

Gas _____

Oil _____

Total Depth 2293

PRODUCTION

1st 24 hrs. Nat. _____

1st 24 hrs. after shot _____

Gas _____ Cu. Ft.

Dry Hole _____

Abandoned _____

Date

MAY 5 1927

CHAS. L. SHERWOOD

192

Scout