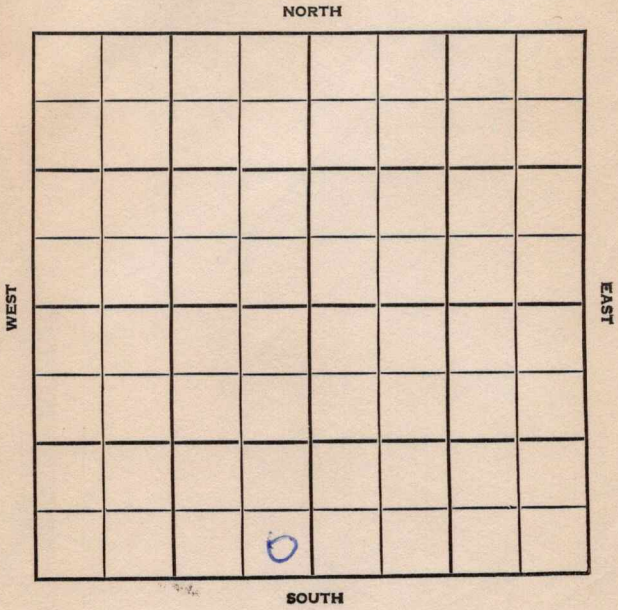


Section 22 Township 13 Range 15WWell No. #1 JohnsonCompany Shelly-Miller

Russell

KANSAS

SEC.	TWP.	R.
22	13	15W

WELL NO.

I Johnson

FARM

COMPANY

Shelly-Miller

CONTRACTOR

Co. Tools


NW Dillner

_____ Ft. from N. Line

_____ Ft. from S. Line

_____ Ft. from E. Line

_____ Ft. from W. Line

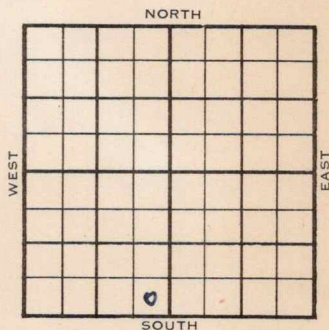

SE SE SW

1955	ELEVATION	REPORT
------	-----------	--------

6/15 Comm 6-13-55
8" @ 286/200

WOC

6/29 DST 3076-3125 open 1 hr. Rec. 50' wcm
270# DST 3156-80 open 1 hr. Rec. 35' wcm
630/20" DST 3314-38 open 1/2 hr. Rec. 25'
mud 0/20" DST 3335-43 open 45 min Rec.
15' mud 0/20" D&A

Tops:	Depth	Datum
Anh.	961	
H.	3022	1115
Tr.	3048	1141
L.	3074	1167
A.	3333	1426
TD.	3343	

ABANDONED

County Russell Elev. _____
 Sec. 22 Twp. 13 Rge. 15W
 Company Shelly-Miller
 Farm Name Johnson No. 1

TOPS	DEPTH	LOG	DATUM	Loc. in Sec.
Anh.				SE SE SW
Tr.				
H.				
Tr.				
Dg.				
BL.				
L.				Geol. _____
K.C.				Contr. _____
B.K.C.				
Ce.				Co. tools
C.				
M.				Pool
M.				
K.				NW Dillner
Mz.				
Mq.				
V.				
S.				
S.				
A.				
R.				
PE.				
G.				
T.D.				

FIRST REPORT
 JUN 15 '55
 0

Date Comm. 6-13-55
8" @ 286/200 WOC

County Russell Elev. 1907 Co. 1
 Sec. 22 Twp. 13 Rge. 15W
 Company Shelly-Miller
 Farm Name Johnson No. 1

TOPS	DEPTH	LOG	DATUM	Loc. in Sec.
Anh.	<u>961</u>			SE SE SW
Tp.				
H.	<u>3022</u>		<u>1145</u>	
Tr.	<u>3048</u>			
Dg.				
Bl.				
L.	<u>3074</u>		<u>1167</u>	Geol.
K.C.				Contr.
B.K.C.				Co. tools
Ce.				Pool
C.				NW Dillner
M.				
M.				
K.				
Mz.				
Me.				
V.				
S.				
S.				
A	<u>3333</u>		<u>1426</u>	
R.				
Pe.				
G.				
T.D.	<u>3343</u>			

Date Comm. 6-13-55 JUN 29 1955
8" @ 286/200 DST 3076-3125 open 1 hr.
Rec. 50' wcm 270# DST 3156-80
open 1 hr. Rec. 35' wm 630/20"
DST 3314-38 open $\frac{1}{2}$ hr. Rec. 25' mud
0/20" DST 3335-43 open 45 min.
Rec. 15' mud 0/20"

D & A