

KANSAS

FORM 51 5M 10-41 PETROL

Greenwood


Section 35 Township 27 Range 8-E

Well No. #19 Lewis "A"

Company K. T. Wiedemann

Miscellaneous

NORTH

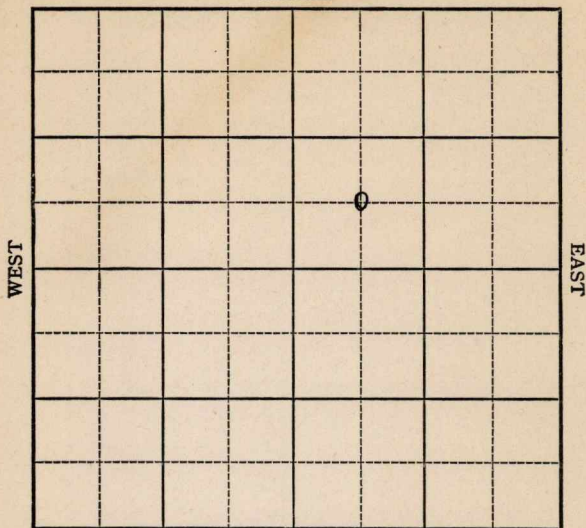

SOUTH

Sec. 35 Twp. 27 R. 8E

Well No. #19 Lewis "A" Farm

K. T. Wiedemann Company


(Miscellaneous)

 Ft. from N. Line

660 Ft. from S. Line

 Ft. from E. Line

660 Ft. from W. Line

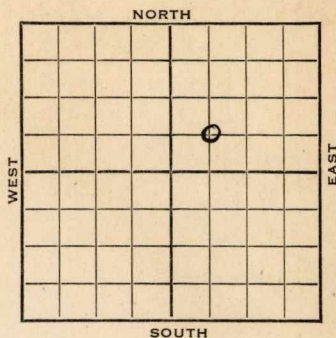

1942	REPORT
9/30	Machine
10/7	Drlg. 690'
10/14	Drlg. 1045' 12" @ 907
10/21	10" @ 1185' Drlg 1375'
10/28	8" @ 1620 Drlg. 1795
11/4	Kc 1750 Bkc 1909-6"@ 2040 Drlg. 2320
11/11	Miss. 2535 5" @ 2536' Drlg. 2660'
11/18	T.D. 2728' Water.
	ABANDONED

KANSAS
 Map No. 10 Sec. 35 Twp. 27 R. 8E

Well No. 19 Lewis "A"

K. T. Wiedemann Company

Contractor

C S W N E

SECTION PLAT

		o	

 Ft. from N. Line

660 Ft. from S. Line

 Ft. from E. Line

660 Ft. from W. Line

MISCELLANEOUS

Location

Rig up

Drilling and Remarks:

Machine

RECORD

Cased in., ft.

Sand

Gas

Oil

Total Depth

PRODUCTION

1st 24 hrs. Nat.

1st 24 hrs. after shot

Gas Cu. Ft.

Dry Hole

Abandoned

Date FIRST REPORTS

S. J. LEWIS

SEP 30 1942 19

Scout

KANSAS

Greenwood

Map No. 10 Sec. 35 Twp. 27 R. 8EWell No. 19 Lewis "A"K. T. Wiedemann CompanyABANDONED Contractor

C SW NE

SECTION PLAT

 Ft. from N. Line660 Ft. from S. Line Ft. from E. Line660 Ft. from W. Line

		6	

MISCELLANEOUS

Location Rig up

Drilling and Remarks:

*Miss 2535**5" @ 2536**Water*

RECORD

Cased in., ft.Sand Gas Oil Total Depth 2728

PRODUCTION

1st 24 hrs. Nat. 1st 24 hrs. after shot Gas Cu. Ft.Dry Hole Abandoned

Date

NOV 1 8 1942

19

S. J. LEWIS

Scout