


Section 35 Township 27S Range 8E
Well No. #39 Lewis "A"
Company Beaumont Pet.

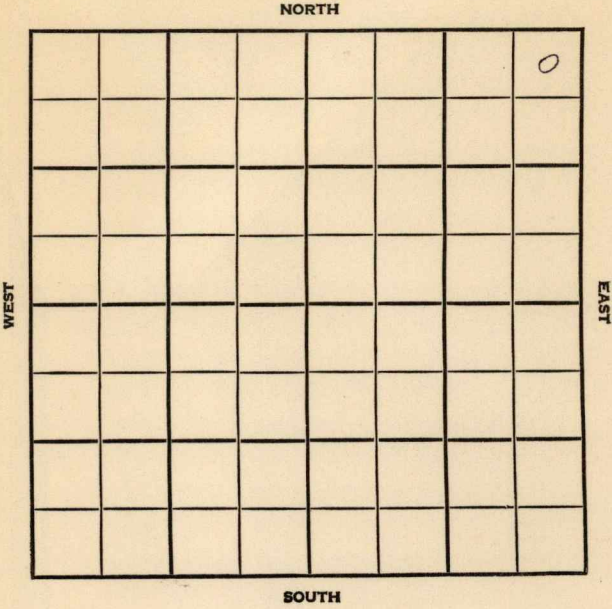

Greenwood

KANSAS

SEC.

35

TWP.

27

R.

8E

WELL NO.

#39 Lewis "A"

FARM

COMPANY

Beaumont Petr.

CONTRACTOR

Beaumont


____ FT. FROM N. LINE

____ FT. FROM S. LINE

____ FT. FROM E. LINE

____ FT. FROM W. LINE

NE NE NE

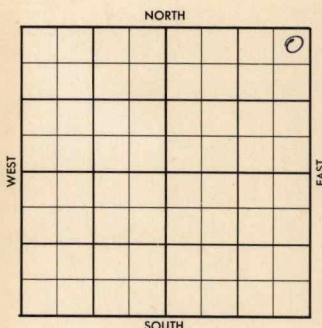

1956

ELEVATION

1437' KB

REPORT

6-13

Location

7-3

10" @ 40 w/50

7" @ 2800 w/40

CO 9/ 2763-2764

P/ 25 BOPD / 25 BWPD

KC. 1669'; BKC 1831', Marm 1979',

Ce. 2155', M. 2425', K. 2700',

A. 2748',

TD 2800'

COMPLETED

County Greenwood Elev. 1437 KB
 Sec. 35 Twp. 27S Rge. 8E
 Company Beaumont Pet.
 Farm Name Lewis "A" No. 39

TOPS	DEPTH	LOG	DATUM	Loc. in Sec.
Anh.				NE NE NE
TP.				
H.				
Tr.				
Dg.				
BL.				
L.				
K.C.	1669			Geol.
B.K.C.	1831			Contr.
Ge. <u>Marm</u>	1979			
G. <u>ce</u>	2155			
M.	2425			
M.				Pool
K.	2700			Beaumont
Mz.				
Ma.				
V.				
S.				
S.				
A.	2748			
R.				
PE.				
G.				
T.D.	2800			

COMPLETE

JUL 3 1956

Date Comm. Loc. JUN 20 '56 10" 40/50

7" @ 2800/40 WOC JUN 27 '56

CO 9/2763-2764 JUL 3 '56

P. 25 BOPD + 25 BOPD

Use.

No.

Sec.


