


Map No. Kansas Sec. 7 Twp. 27 R. 10Well No. 1 Weaver FarmH. E. Griffith Company

NORTH

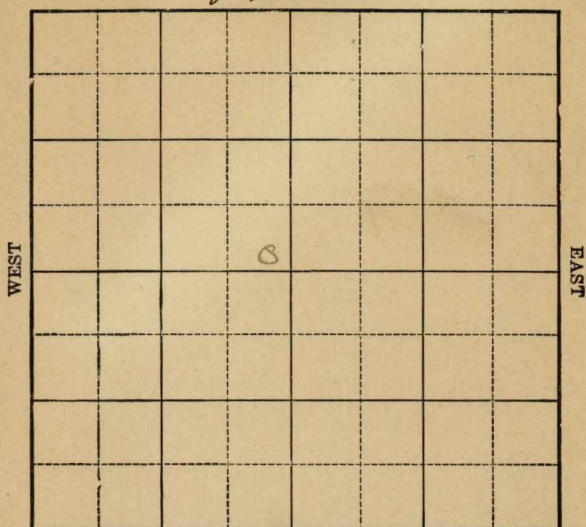

SOUTH

Location _____

Drilling Remarks _____

Rig Up _____

Drilling Remarks _____

RECORD

Cased _____ in. _____ ft.

Sand _____

Gas _____

Oil _____

Total Depth _____

PRODUCTION

1st 24 hrs. Nat. _____

1st 24 hrs. after shot _____


Gas _____ cu. ft.

Dry Hole _____

Abandoned _____

Map No. Kansas Sec. 7 Twp. 27 R. 10Well No. 1 Weaver FarmA.E. Griffith Company

NORTH

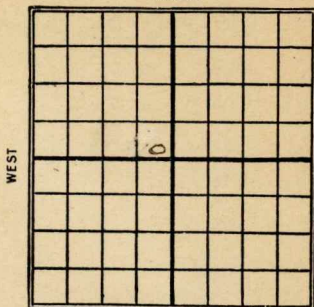

Ft. from N. Line

250 Ft. from S. Line250 Ft. from E. Line

Ft. from W. Line

SOUTH

1926

{cows}

Date

REPORT

7/14	location
7/22	—
7/28	Rig
8/4	—
8/11	rigging up
8/18	Spudding
8/25	same
8-31	—
9/15	—
9/22	same
9/29	same
10/13	same
10/26	same
11/11	S.D. 310
11/17	—
11/23	same
12/8	same
12/15	—
12/22	Abnd 310'
1927	{cows}
5/18	Sly 1000 feet
5/25	W.R. 1140

6/1 - S.D. 1140

6/7 Drlg 1405

6/15 - S.D. 1500

6/22 —

6/29 - Drlg 2100

7/7 - Top line 2190-

W. & A. 2244

Skeewood

K9 KANSAS
 Map No. _____ Sec. 7 Twp. 27 R. 10
 Well No. 1

H. E. Griffith

Company

Contractor

FIRST REPORTS

SECTION PLAT

_____ Ft. from N. Line

250 _____ Ft. from S. Line

250 _____ Ft. from E. Line

_____ Ft. from W. Line

Location ✓ _____

Rig up _____

Drilling and Remarks:

RECORD

Cased _____ in., _____ ft.

Sand _____

Gas _____

Oil _____

Total Depth _____

PRODUCTION

1st 24 hrs. Nat. _____

1st 24 hrs. after shot _____

Gas _____ Cu. Ft.

Dry Hole _____

Abandoned _____

Date

JUL 14 1926

CHAS. L. SHERWOOD

192

Scout

9 **KANSAS** Map No. _____ Sec. 7 Twp. 27 R. 10

Well No. 1 weaver
4. E. Sniffith _____ Company

Contractor

COMPLETED

SECTION PLAT

_____ Ft. from N. Line

250 _____ Ft. from S. Line

250 _____ Ft. from E. Line

_____ Ft. from W. Line

ABANDONED

Location _____

Rig up _____

Drilling and Remarks:

RECORD

Cased _____ in., _____ ft.

Sand _____

Gas _____

Oil _____

Total Depth 310 _____

PRODUCTION

1st 24 hrs. Nat. _____

1st 24 hrs. after shot _____

Gas _____ Cu. Ft.

Dry Hole _____

Abandoned ✓ _____

Date

DEC 22 1926

CHAS I SHERWOOD

192

Scout

and a 310
Acct gun si.

Greenwood E

 9 **KANSAS**
 Map No. _____ Sec. 7 Twp. 27 R. 10

 Well No. 1 *Weaver*
Higgins @ *HW* _____ Company

Contractor**FIRST REPORTS****SECTION PLAT**_____
Ft. from N. Line

250

Ft. from S. Line

250

Ft. from E. Line_____
Ft. from W. Line

	0		

old Hole Deepen

Location _____

Rig up _____

Drilling and Remarks:

*Dlg 1000'**Formerly Carried
as H.C. Siggith***RECORD**

Cased _____ in., _____ ft.

Sand _____

Gas _____

Oil _____

Total Depth _____

PRODUCTION

1st 24 hrs. Nat. _____

1st 24 hrs. after shot _____

Gas _____ Cu. Ft.

Dry Hole _____

Abandoned _____

Date

MAY 18 1927

CHAS. L. SHERWOOD

192

Scout

Map No. **9 KANSAS** Sec. **7** Twp. **27** R. **10**
 Well No. **1 Weaver**

Higgins et al Company

Contractor

COMPLETED

SECTION PLAT

----- Ft. from N. Line

250 Ft. from S. Line

250 Ft. from E. Line

----- Ft. from W. Line

ABANDONED

O.W.R.D.

Location -----

Rig up -----

Drilling and Remarks:

Top lens 2195

STH 2244

RECORD

Cased ----- in., ----- ft.

Sand -----

Gas -----

Oil -----

Total Depth **2244**

PRODUCTION

1st 24 hrs. Nat. -----

1st 24 hrs. after shot -----

Gas ----- Cu. Ft.

Dry Hole -----

Abandoned -----

Date

July 7 1927

CHAS. L. SHERWOOD

Scout