


Section 35 Township 27 Range 8E

Well No. #29 Lewis, "A"

Company K. T. Weidemann

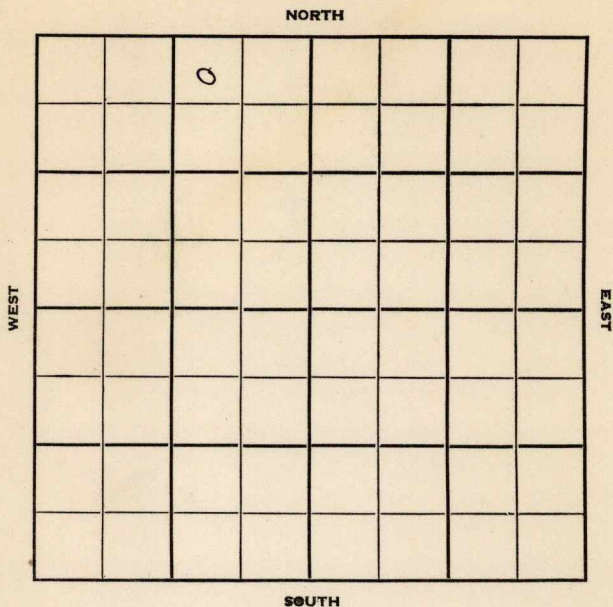

Greenwood

KANSAS

Sec. 35

Twp. 27

R. 8E

Well No. #29 Lewis "A" Farm

K.T. Weidemann Company

Contractor


330' Ft. from N. Line

Ft. from S. Line

990' Ft. from E. Line

Ft. from W. Line

NW NE NW

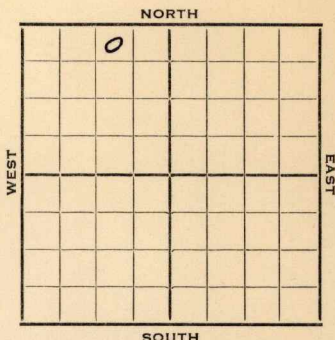

1952

Elev. -

REPORT

2/20

Location

4/2

Spud 2-22-52

Oil Well TD 1790

8" @ 30 Prue 1779 TD 1780

5" @ 1780 DD 1790 Hydro.

Comp. 10 BOPD

COMPLETED

County Greenwood State KansasSec. 35 (Blk. Twp.) 27 (Sur. Rge.) 8E Map No.Operator K. T. WeidemannWell No. 29 Farm Lewis "A"Elev. Location NW NE NW

		0			

330 Ft. From N Line NW990 Ft. From E Line Quarter1st. Report FEB 20 1952

Completion

Remarks

Spudding Date

Drlg. Data

Location

J. G. McGEHEE

County Greenwood State KansasSec. 35 (Blk. Twp.) 27 (Sur. Rge.) 8E Map No.Operator K. T. WeidemannWell No. 29 Farm Lewis "A"Elev. Location NW NE NW

	0				

330 Ft. From N Line NW

990 Ft. From E Line Quarter

1st. Report

Completion APR 2 1952

Remarks

Spudding Date 2-22-52Drlg. Data Oil well TD 1790

8" @ 30 Prue 1779 TD 1780 5" @ 1780

DD 1790 Hydro. Comp. 10 bopd

J. G. McGEHEE