

SAS

Form 51-5M-7-39-Palace


Greenwood

Section 36 Township 27 Range 8-E

Well No. #2 Lewis

Company Sam Molter

NORTH **Miscellaneous**

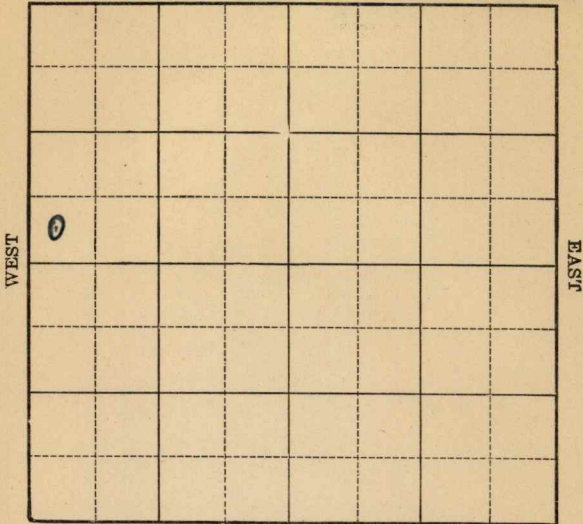

SOUTH

Sec. 36 Twp. 27 R. 8-E

Well No. #2 Lewis Farm

Sam Molter Company


(Misc.)

_____ Ft. from N. Line

330 Ft. from S. Line

_____ Ft. from E. Line

330 Ft. from W. Line

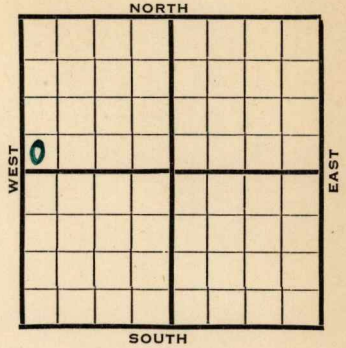

1940	REPORT
3/1	RUST.
5/9	Spud.
5/16	Spud 350'
5/23	Drlg. 770'
5/29	12" - 870' C.O.
6/6	SD 1000'
6/13	10" - 1045' 8" - 1383'
	Lansing 1425' Drlg. 1680'
6/20	K.C. 1690' S.O. 1745-55'
	B.K.C. 1690' Peru 1810-53'
	T.D. 1860'
	Shot 30 qts. 1823-53'
	Split csg. Fishing.
6/27	6" - 1745' P.B.P.
7/3	1790' - 50' oil. 1000 acid.

OVER

1940

7/10

Peru sand 1810'

T.D. 1860'

Shot 30 qts. 1823-53'

6" - 1745'

1000 acid.

6 bbls. oil & 60 water.

COMPLETED

Map No. 10 Sec. 36 Twp. 27 R. 8E

Well No. 2 Lewis

Sam Molter Company

Contractor

FIRST REPORT

SW COR. NW

 Ft. from N. Line

330 Ft. from S. Line

 Ft. from E. Line

330 Ft. from W. Line

SECTION PLAT

MISCELLANEOUS

Location

Rig up

Drilling and Remarks:

RUST

RECORD

Cased in., ft.

Sand

Gas

Oil

Total Depth

PRODUCTION

1st 24 hrs. Nat.

1st 24 hrs. after shot

Gas Cu. Ft.

Dry Hole

Abandoned

Date

MAY 1 1940 19

S. J. LEWIS Scout

