


Section 36 Township 27 Range 8E

Well No. #30 Lewis

Company K. T. Weideman

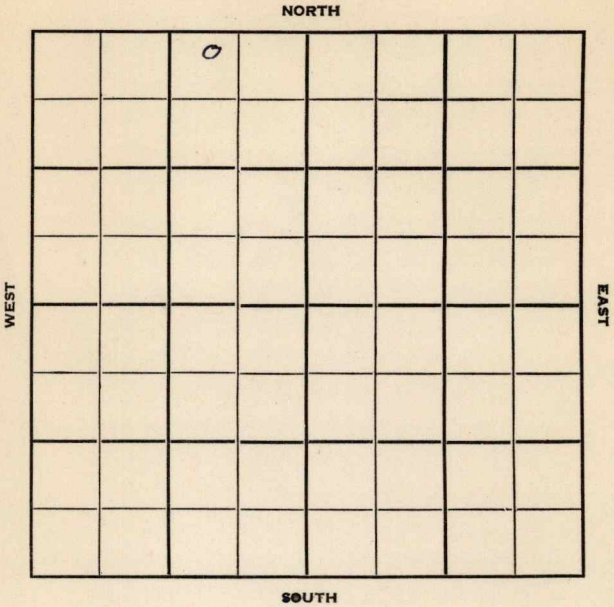

Greenwood

KANSAS

8E

Sec. 36 Twp. 27 R. Y

Well No. #30 Lewis Farm

K. T. Weideman

Company

Contractor


100 Ft. from N. Line

900 Ft. from S. Line

900 Ft. from E. Line

Ft. from W. Line

NW NE NW

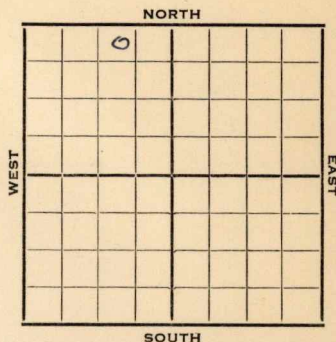

1952

Elev. -

REPORT

4/2

Spud 3-23-52

8" @ 32' KC 1681 Prue sd 1830

RTD 1833 5" @ 1830'

4/16

Spud 3-23-52

Oil Well TD 1856

8" @ 32

KC 1681 Prue Sand 1830

TD 1833 5" @ 1830

DD 1856 Hydra Comp. 10 bopd

COMPLETED

County **Greenwood** State **Kansas**
 Sec. **36** (Blk.) **27** (Sur.) **8E** Map No.

Operator **K. T. Weideman**

Well No. **30** Farm **Lewis**

Elev. Location **NW NE NW**

	0						

FIRST REPORT

100 Ft. From **N** Line **NW**
900 Ft. From **E** Line Quarter

1st. Report **APR 2 1952**

Completion

Remarks

Spudding Date **3-23-52**

Drlg. Data

8" @ 32 KC 1681 Prue sd 1830 RTD 1833
5" @ 1830

J. G. McGEHEE

County Greenwood State KansasSec. 36 (Blk. Twp.) 27 (Sur. Rge.) 8E Map No.Operator K. T. WeidemannWell No. 30 Farm LewisElev. Location NW NE NW

		0				

100 Ft. From N Line NW900 Ft. From E Line Quarter

1st. Report

Completion APR 16 1952

Remarks

Spudding Date 3-23-52Drilg. Data Oil well TD 18568" @ 32 KC 1681 Prue sand 1830TD 1833 5" @ 1830 DD 1856 Hydro.Comp. 10 bopd

J. G. McGEHEE