


Map No. 1- **KANSAS** Sec. 24 Twp. 13 R. 15W
Well No. Mc Allister Farm
Hartman & Blair Company

Russell
15W

NORTH

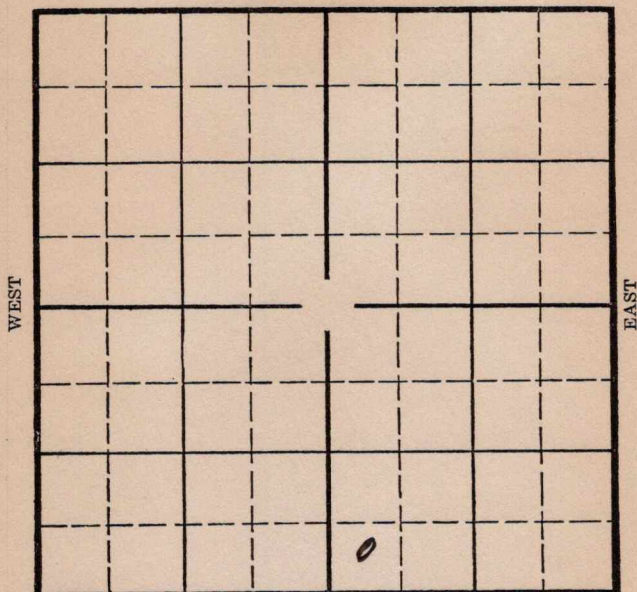

SOUTH

Location _____
Drilling Remarks _____

Rig Up _____
Drilling Remarks _____

RECORD

PRODUCTION

Cased _____ in. _____ ft.
Sand _____
Gas _____
Oil _____
Total Depth _____

1st 24 hrs. Nat. _____
1st 24 hrs. after shot _____
Gas _____ cu. ft. _____
Dry Hole _____
Abandoned _____

Russell

Map No. **KANSAS** Sec. 24 Twp. 13 R. 15 W
Well No. 1- Mc Allister Farm
Hartman & Blair Company


 Ft. from N. Line

330 Ft. from S. Line

 Ft. from E. Line

330 Ft. from W. Line

Elev. 1882

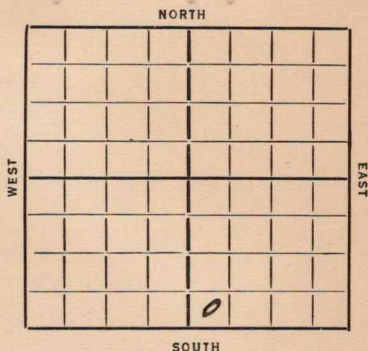

REPORT

1935
12/23 Moving In
1/2/36 —
1/10 Allen & Mat
1/17 —
1/24 Allen
1/31 — 2/7 —
2/14 M J Tools
2/21 — 2/28 — 3/6 — 3/13 —
3/20 Rig.
3/27 --
4/2 -- 4/10 -- 4/16 -- ~~4/23~~ --
4/23 Rigging up.
4/30 --
5/7 Drlg. 470'.
5/14 12" @ 530' - 10" @ 950'. Drlg. 1130'.
5/21 Drlg. 1995'.
5/28 8" @ 2280'. Drlg. 2425'.
6/4 2505'. Under reaming 8".
6/11 Drlg. 2890'.

OVER

736002

7/8/36-Sil. 3318'.

H.F.W. 3340-42'.

T.D. 3342'.

D & A

ABANDONED

Map No. 72 Sec. 24 Twp. 13 R. 15ⁿWell No. 1-McAllisterHartman + Blair Company

Contractor

FIRST REPORTS

Ft. from N. Line

330 Ft. from S. Line

Ft. from E. Line

330 Ft. from W. Line

SECTION PLAT

		0	

Location

Rig up

Drilling and Remarks:

Moving in

RECORD

Cased _____ in., _____ ft.

Sand _____

Gas _____

Oil _____

Total Depth _____

PRODUCTION

1st 24 hrs. Nat. _____

1st 24 hrs. after shot _____

Gas _____ Cu. Ft.

Dry Hole _____

Abandoned _____

Date

ORVAL MANNSCHRECK

12-23-35 192 _____ Scout

Map No. 72 Sec. 24 Twp. 13 R. 15WWell No. 1st McAllisterHartman & Blair Company

Contractor

SECTION PLAT

		0	

_____ Ft. from N. Line

330 Ft. from S. Line

_____ Ft. from E. Line

330 Ft. from W. Line~~ABANDONED~~

Location _____

Rig up _____

Drilling and Remarks:

Sil 3318.AFW 3340-42J & H.

RECORD

Cased _____ in., _____ ft.

Sand _____

Gas _____

Oil _____

Total Depth 3342

PRODUCTION

1st 24 hrs. Nat. _____

1st 24 hrs. after shot _____

Gas _____ Cu. Ft.

Dry Hole _____

Abandoned _____

Date

JUL 8 1936S. J. LEWIS

Scout