
KANSAS Russell

FORM 51 25M 3-49 PETROL

Section 24 Township 13 Range 15-W

Well No. #4 McAllister

Company Great Lakes Carbon

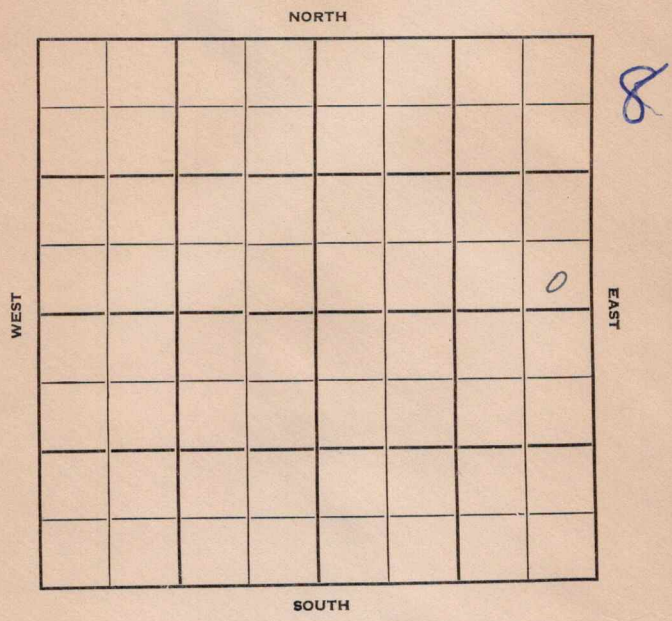

FORM 252-A
5M 10-48 PETROL


Russell KANSAS

Sec. 24 Twp. 13 R. 15W

Well No. #4 McAllister Farm

Great Lakes Carbon Company

Atherton Pool

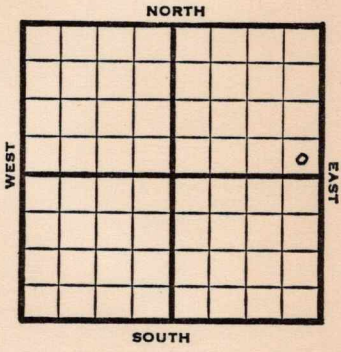

_____ Ft. from N. Line

330' Ft. from S. Line

330' Ft. from E. Line

_____ Ft. from W. Line

SE SE NE

1950	Elev 1823' REPORT
1/11	Spud 1-8-50 8" @ 360' WOC
2/8	TD 3305' 8"@ 360' 5"@ 3305' Hub 2942' Lans 2999' Arb. 3252' D&A Aband.

ABANDONED

Form 26 200 Bks. 6-49 Petrol

Kansas

Atherton Pool

Map No. _____ Sec. 24 Twp. 13 R. 15W

Well No. 4 McAllister

Great Lakes Carbon Company

Contractor

SE SE NE

SECTION PLAT



_____ Ft. from N. Line

330 Ft. from S. Line

330 Ft. from E. Line

_____ Ft. from W. Line

Russell County

Location

Rig up

Drilling and Remarks:

Spud 1-8-50

8" @ 360 WOC

RECORD

Cased _____ in., _____ ft.

Sand

Gas

Oil

Total Depth

PRODUCTION

1st 24 hrs. Nat.

1st 24 hrs. after shot

Gas _____ Cu. Ft.

Dry Hole

Abandoned

Date

JAN 11 1950 19

J. E. TYRA Scout

Form 26 200 Bks. 11-49 Petrol

Atherton Pool

Kansas

Map No. _____ Sec. 24 Twp. 13 R. 15W

Well No. 4 McAllister


Great Lakes Carbon Company

_____ Contractor

SE SE NE

El. 1823

SECTION PLAT

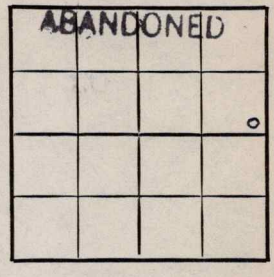

_____ Ft. from N. Line

330 Ft. from S. Line

330 Ft. from E. Line

_____ Ft. from W. Line

Russell County

Location _____

Rig up _____

Drilling and Remarks:

8" @ 360
5" @ 3305
Kueb 2942
Lans 2999
Arb 3252
D & A

RECORD

Cased _____ in., _____ ft.

Sand _____

Gas _____

Oil _____

Total Depth 3305

PRODUCTION

1st 24 hrs. Nat. _____

1st 24 hrs. after shot _____

Gas _____ Cu. Ft.

Dry Hole _____

Abandoned _____

Date

FEB 8 1950 19

J. E. TYRA Scout