

Russell

FORM 51 25M 3-49 PETROL

KANSAS

Section 24 Township 13 Range 15W

Well No. #1 Olson

Company B-H-P Oil

NORTH

SOUTH

WEST

EAST

9

0

KANSAS

Russell
15-W

Sec. 24 Twp. 13 R. 15-W

Well No. #1 Olson Farm
B-H-P Oil Company


330 Ft. from N. Line

 Ft. from S. Line

990 Ft. from E. Line

 Ft. from W. Line

NW NE SE

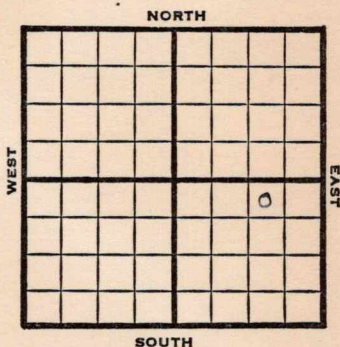

1950

Elev 1830

R E P O R T

7/26

Drlg

9/6

TD 3294

8" @ 160

Anhy 885

Cong 3261

5 1/2" @ 3274

TD 3294

D&A

KC 3002

Arb 3273

ABANDONED

ansan

Map No. _____ Sec. 24 Twp. 13 R. 15WWell No. 1 OlsonB-H-P Oil

Company _____

Contractor _____

NW NE SE

SECTION PLAT

330 Ft. from N. Line

_____ Ft. from S. Line

990 Ft. from E. Line

_____ Ft. from W. Line

Russell County

Location _____

Rig up _____

Drilling and Remarks:

drlg.

RECORD

Cased _____ in., _____ ft.

Sand _____

Gas _____

Oil _____

Total Depth _____

PRODUCTION

1st 24 hrs. Nat. _____

1st 24 hrs. after shot _____

Gas _____ Cu. Ft.

Dry Hole _____

Abandoned _____

Date

JUL 26 1950
JUL 26 1950 19J. E. TYRA

Scout

County Russell State Kansas
 Sec. 24 (Blk.) 13 (Sur.) 15W Map No.
 Operator B-H-P Oil
 Well No. 1 Farm Olson
 Elev. 1830 Location NW NE SE



330 Ft. From N Line SE
990 Ft. From E Line Quarter

1st. Report

Completion SEP 6 1950

Remarks

Atherton Pool

Spudding Date

Drlg. Data D & A TD 3294
8" @ 160 Anhy 885 KC 3002 Cong. 3261
Arb. 3273 5½" @ 3274 TD 3294
D & A

J. E. TYRA