


Section 36 Township 27 Range 8E

Well No. #22 Lewis "A"

Company K. T. Weideman

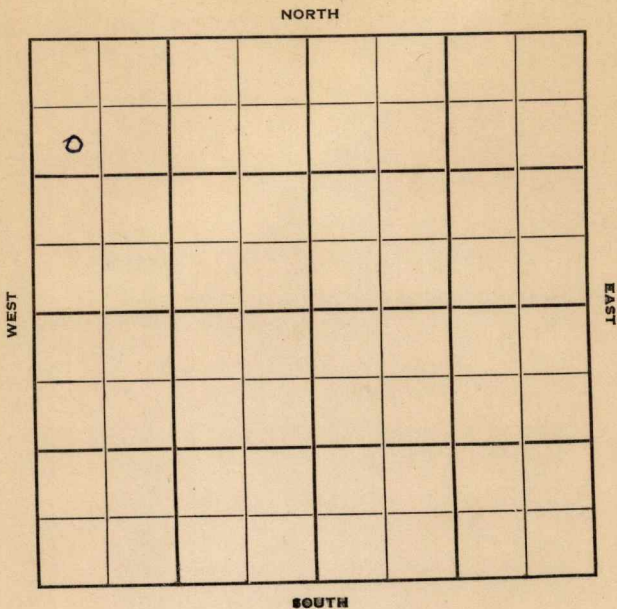

Greenwood **KANSAS**

Sec. 36 Twp. 27 R. 8E

Well No. #22 Lewis (A) Farm

K. T. Weideman Company

Contractor


990' Ft. from N. Line

\_\_\_\_\_ Ft. from S. Line

\_\_\_\_\_ Ft. from E. Line

450' Ft. from W. Line

SW NW NW

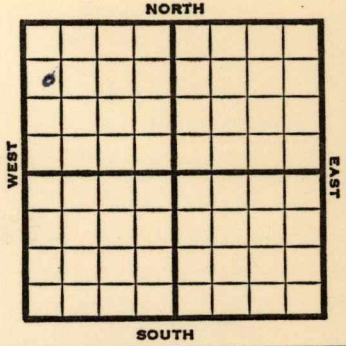

1951

REPORT

9/19 10" @ 54'  
 10/17 Oil well TD 2482  
 10" @ 54  
**Miss. 2436**  
 7" @ 2433  
 TD 2482 4000 A  
 Comp. 15 BOPD

**COMPLETED**



County Greenwood State Kansas

Sec. 36 (Blk. 27) (Sur. 8E) (Twp.) (Rge.) Map No.

Operator K. T. Weidemann

Well No. 22 Farm Lewis "A"

Elev. \_\_\_\_\_ Location SW NW NW


990 Ft. From N Line NW

450 Ft. From W Line Quarter

1st. Report

Completion OCT 17 1951

Remarks

Spudding Date

Drilg. Data Oil well TD 2482

10" @ 54 Miss. 2436 7" @ 2433

TD 2482 4000 A Comp. 15 bopd

COMPLETE

J. E. TYRA