


Greenwood

**KANSAS**

SECTION 36 TOWNSHIP 27 RANGE 8E

WELL NO. #4 Molter-Ledgewood

COMPANY Beaumont Petro.

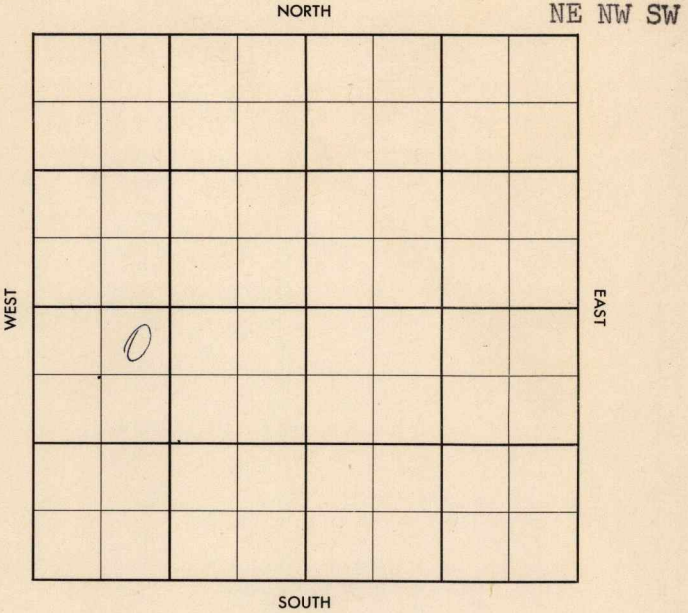

County Greenwood Elev. \_\_\_\_\_  
 Sec. 36 Twp. 27 Rgs. 8E  
 Company Beaumont Petroleum  
 FarmName Molter-Ledgewood No. 4

TOPS	DEPTH	LOG	DATUM	Loc. in Sec.
Anh.				NE NW SW
TP.				
H.				
Tr.				
Dg.				
Bl.				
L.				Geol. _____
K.C.				Contr. _____
B.K.C.				
Ce.				Co. Tools _____
C.				
M.				Pool _____
M.				Beaumont
K.				
Mz.				
Me.				
V.				
S.				FIRST REPORT
S.				
A.				MAY 15 '57
R.				
PE.				
G.				
T.D.				

Date Comm. 5-11-57  
10" @ 40' / Drlg. 1590

~~30~~

Co.  
Lse.  
No.  
Sec.  
T.  
R.

Co.

County Greenwood Elev. 1421 RB  
 Sec. 36 Twp. 27 Rgs. 8E  
 Company Beaumont Petroleum  
 Farm Name Molter-Ledgewood No. 4

TOPS	DEPTH	LOG	DATUM	Loc. in Sec.																												
Anh.				NE NW SW																												
Tp.																																
H.																																
Tr.																																
Dg.																																
BL.																																
L.				Geol.																												
K.C.	1675			Contr.																												
K.C.C.	1830			Co. Tools																												
Ce. <u>Peru</u>	1835																															
C. <u>Marm</u>	1975			Pool																												
M. <u>ce</u>	2175																															
M.	2422			Beaumont																												
K.	2668																															
Mz.				<table border="1"> <tr> <td colspan="2" rowspan="2">ABANDONED</td> <td></td> </tr> <tr> <td></td> </tr> <tr> <td></td> <td></td> <td></td> </tr> <tr> <td></td> <td></td> <td></td> </tr> <tr> <td></td> <td></td> <td></td> </tr> <tr> <td></td> <td></td> <td></td> </tr> <tr> <td></td> <td></td> <td></td> </tr> <tr> <td></td> <td></td> <td></td> </tr> <tr> <td></td> <td></td> <td></td> </tr> <tr> <td></td> <td></td> <td></td> </tr> </table>	ABANDONED																											
ABANDONED																																
V.																																
S.																																
S.																																
A.	2720																															
R.																																
PE.																																
G.																																
T.D.	2785																															

Lse.

No.

Sec.

T.

R.

Date Comm. 5-11-57  
 10" @ 40, Dr. 1590 MAY 22 '57 7" @ 2785  
 135 MAY 29 '57 JUN 3 '57 W O C T JUN 12 '57 C O  
 25/2725-28 114 1st 1st JUN 19 '57  
1st 1st wt sqg. JUN 27 '57 C O  
 18/2761-65 7/2748-50 no show  
 PF 2739-41 E 2732-34  
 530 wt PB 2735 1st no show  
 59d 2732-34 C O JUL 3 '57 1st  
 All wt P & A