


Russell County Kansas

Form 51-5M 5-37 Petrol

Section 23 Township ~~14~~ 13 Range 15W

Well No. 1 Boxberger "B"

Company Empire

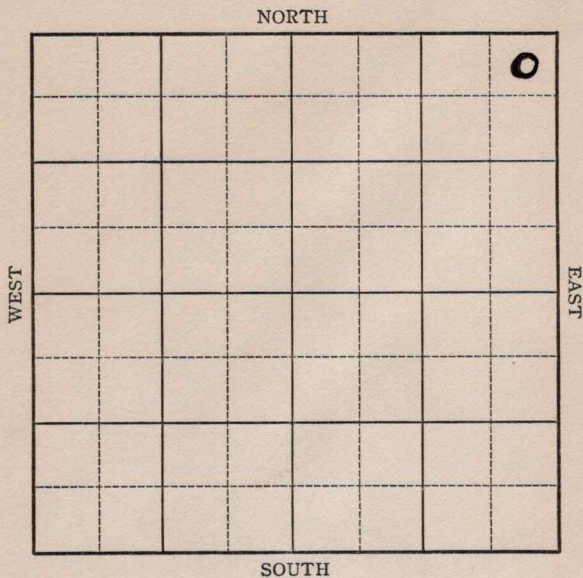

Sec. 23 Twp. 13 R. 15 -W

Well No. #1 Boxberger "B" Farm

Empire Company


330 Ft. from N. Line

\_\_\_\_\_ Ft. from S. Line

330 Ft. from E. Line

\_\_\_\_\_ Ft. from W. Line

Elev. 1846

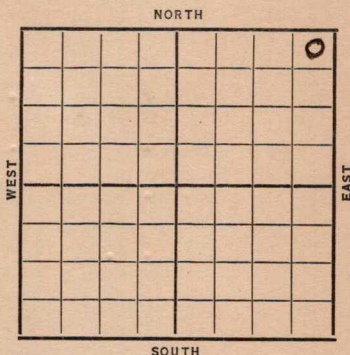

Date	REPORT
1937	
7/28	Location
8/6	B. R.
8/13	R. U.
8/20	T.D. 315'. Rng. 15".
8/28	15" @ 316'. 12" @ 568'.
	Drlg. 730'.
9/3	Anhy 907'. 12" @ 917'.
	Drlg. 1355'.
9/10	Drlg. 1990'.
9/17	10" @ 2502'. Drlg. 2525'.
9/24	Dodge 2995'. K.C. 3025'.
	8" @ 3025'. C.O.
10/2	7" @ 3259'. Sil. 3295'.
	9 B.W. 2 hrs 3343-47'.
	Drlg. 3350'.

OVER

736011

1937

10/6 7" @ 3259'.

Sil. 3295'.

T.D. 3350'.

9 B.W. 2 hrs. 3343-47'.

**ABANDONED**



Russell

KANSAS

Map No. 72 Sec. 23 Twp. 13 R. 15W

Well No. 1 Boxberger "B"

Empire Company

Contractor

ABANDONED

NE/C

SECTION PLAT

			0

330 Ft. from N. Line

\_\_\_\_\_ Ft. from S. Line

330 Ft. from E. Line

\_\_\_\_\_ Ft. from W. Line

Location \_\_\_\_\_

Rig up \_\_\_\_\_

Drilling and Remarks:

9 B.W. - 2 hrs

3343-47

D & A

RECORD

Cased 7 in., 3259 ft.

Sand 511 3295

Gas \_\_\_\_\_

Oil \_\_\_\_\_

Total Depth 3350

PRODUCTION

1st 24 hrs. Nat. \_\_\_\_\_

1st 24 hrs. after shot \_\_\_\_\_

Gas \_\_\_\_\_ Cu. Ft.

Dry Hole \_\_\_\_\_

Abandoned \_\_\_\_\_

Date

OCT - 6 1937