

KANSAS

Russell


Section 24 Township 13 Range 15-W

Well No. #1 H Krug

Company Great Lakes Carbon

Atherton Pool

NORTH

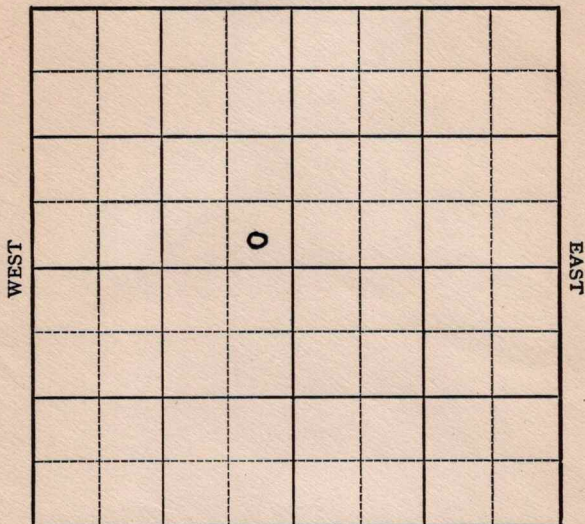

KANSAS

Russell ✓

Sec. 24 Twp. 13 R. 15W

Well No. 1 H. Krug Farm

Great Lakes Carbon Company

Atherton Pool

NORTH


 Ft. from N. Line

330 Ft. from S. Line

330 Ft. from E. Line

 Ft. from W. Line

SE NW

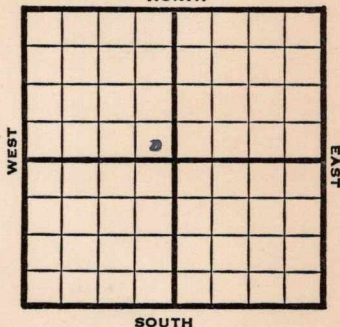

1949

Elev. 1831' REPORT

8/24

8" @ 367

Drlg. 940'

8/31

Lansing 3004'

Drlg. 3110'

9/7

ReArb 3282'

TD 3345'

ABANDONED

Map No. _____ Sec. 24 Twp. 13 R. 15W

Well No. 1 H. Krug

Great Lakes Carbon Company

Contractor

FIRST REPORT

SECTION PLAT


SE NW

_____ Ft. from N. Line

330 Ft. from S. Line

330 Ft. from E. Line

_____ Ft. from W. Line

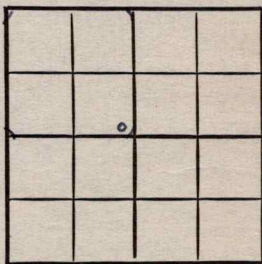

Russell County

RECORD

Location _____

Cased _____ in., _____ ft.

Rig up _____

Sand _____

Drilling and Remarks:

Gas _____

8" @ 367

Oil _____

Total Depth _____

drlg. 940

PRODUCTION

1st 24 hrs. Nat. _____

1st 24 hrs. after shot _____

Gas _____ Cu. Ft.

Dry Hole _____

Abandoned _____

Date

AUG 24 1949 19

S. J. LEWIS

Scout

Kansas

Map No. K 72 Sec. 24 Twp. 13 R. 15WWell No. 1 H. Krug


Great Lakes Carbon

Company

ABANDONED

Contractor

SE NW

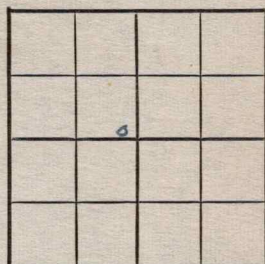E 1/831
SECTION PLAT

_____ Ft. from N. Line

330 Ft. from S. Line330 Ft. from E. Line

_____ Ft. from W. Line

Russell County

Location _____

Rig up _____

Drilling and Remarks:

See 8252

RECORD

Cased _____ in., _____ ft.

Sand _____

Gas _____

Oil _____

Total Depth 334.5

PRODUCTION

1st 24 hrs. Nat. _____

1st 24 hrs. after shot _____

Gas _____ Cu. Ft.

Dry Hole _____

Abandoned _____

Date

SEP 7 1949 19

S. J. LEWIS Scout