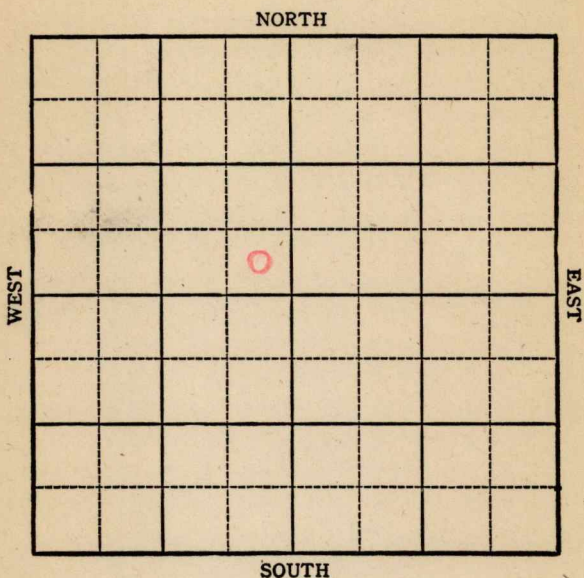


KANSAS

Greenwood

Section 2 Township 27 Range 9EWell No. #1 MausCompany Producers Supply

KANSAS

Greenwood

Sec. 2 Twp. 27 R. 9E

Well No. #1 Maus Farm

Producers Supply Company


Miscellaneous

 Ft. from N. Line

330 Ft. from S. Line

330 Ft. from E. Line

 Ft. from W. Line

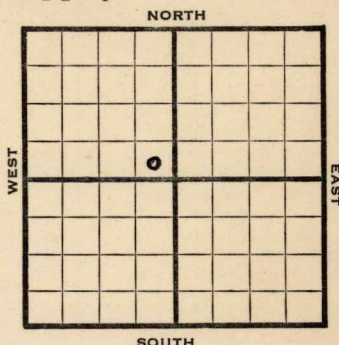

1944

REPORT

7/26 Drilling 450

8/2 Drlg. 628

8/9 Drlg. 710 12" @ 700

8/16 Drlg. 865

8/23 865 SD

8/30 Drlg. 1000'

9/8 1000' NR 10"

9/13 Drlg. 1200'

9/21 1200' SD

10" @ 1000'

9/28 Drlg. 1350

10/4 Drlg. 1700

10/11 SD repairs

10/18 " "

10/25 Bart 1850

Miss 2265

Drlg. 2330

Arb. 2634

TD 2640

HFW

11/8

ABANDONED

Pool Name Miscellaneous

KANSAS
 Map No. 10 Sec. 2 Twp. 27 R. 9E


Well No. 1 Maus

Producers Supply Company

FIRST REPORT Contractor

SE NW

SECTION PLAT

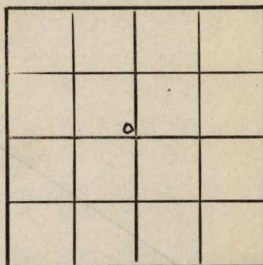

Ft. from N. Line

330

Ft. from S. Line

330

Ft. from E. Line

Ft. from W. Line

Greenwood County

Location West Well

Rig up

Drilling and Remarks:

450'

RECORD

Cased _____ in., _____ ft.

Sand _____

Gas _____

Oil _____

Total Depth _____

PRODUCTION

1st 24 hrs. Nat. _____

1st 24 hrs. after shot _____

Gas _____ Cu. Ft.

Dry Hole _____

Abandoned _____

Date

JUL 26 1944

19

S. J. LEWIS

Scout

Pool Name MiscellaneousMap No. 16 Sec. 2 Twp. 27 R. 9EWell No. 1 MausProducers Supply Company

ABANDONED

Contractor

SE NW

SECTION PLAT

 Ft. from N. Line330 Ft. from S. Line330 Ft. from E. Line Ft. from W. Line

GreenwoodLocation Rig up

Drilling and Remarks:

See X2634XJW

RECORD

Cased in., ft.Sand Gas Oil Total Depth 2640

PRODUCTION

1st 24 hrs. Nat. 1st 24 hrs. after shot Gas Cu. Ft.Dry Hole Abandoned

Date

NOV 8 1944 19S. J. LEWIS Scout