

Sec. 6 Twp. 27 Range 9 E

#1 Baldwin

Kansas Geological Society

Edwards, et al.


Skelly Scout Tickets

1-8-17-5M

Map No. _____ Sec. 6 Twp. 27 R. 9

Well No. 1 Baldwin Farm
Edwards et al Company

NORTH

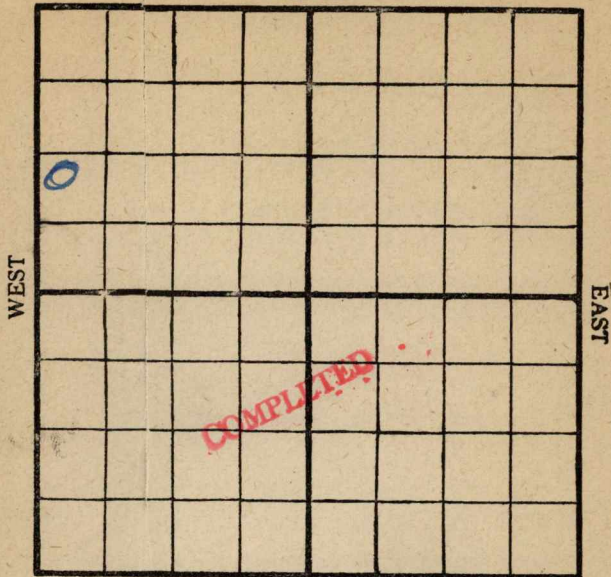

SOUTH

Location _____

Rig Up _____

Drilling Remarks:

Drilling Remarks:

Map No. _____ Sec. 6 Twp. 27 R. 9

Well No. 1. Baldwin Farm

Edwards Oil Co Company

Contractor


NW Quarter

Ft. from N. Lice

1080 Ft. from S. Line

Ft. from E. Line

250 Ft. from W. Line

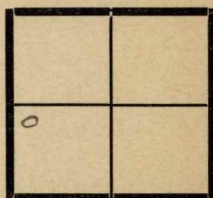

Date 1919

REPORT

1911 Rig up

1919 Rig moved away Abandoned


COMPLETED

Map No. K10 Sec. 6 Twp. 27 R. 9
 Well No. 1 Baldwin Farm
Edwards et al Company

NORTH

WEST

EAST

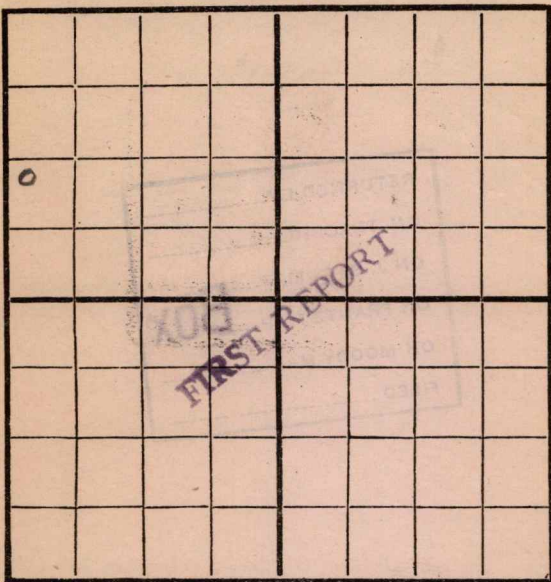

SOUTH

Location ☒
 Rig Up
 Drilling and remarks

RECORD

Cased _____ in. _____ Ft.
 Sand _____
 Gas _____
 Oil _____
 Total Depth _____


PRODUCTION

1st 24 hrs. Nat. _____
 1st 24 hrs. after shot _____
 Gas _____ Cu. Ft.
 Dry Hole _____
 Abandoned _____

Date

4/22, 1918 Oy a Scout

Map No. K10 Sec. 6 Twp. 27^S 9^E
 Well No. 1 Baldwin
Edwards et al Company
 Contractor

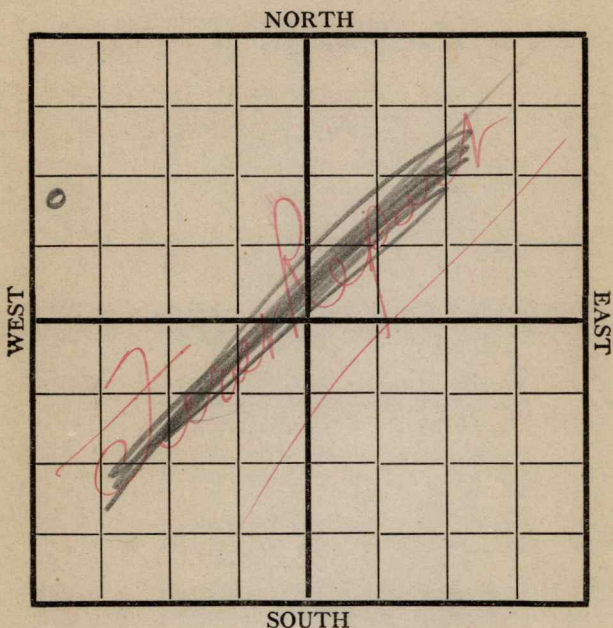

Location

250 E 1070 N

Rig up

Drilling and Remarks:

RECORD

Cased _____ in., _____ ft.

Sand _____

Gas _____

Oil _____

Total Depth _____

PRODUCTION

1st 24 hrs. Nat. _____

1st 24 hrs. after shot _____

Gas _____ Cu. Ft.

Dry Hole _____

Abandoned _____

Date

8/31

191


Pyle

Scout

Map No. K10 Sec. 6 Twp. 27 R. 9
 Well No. 1 Baldwin Farm
Edwards et al Company

NORTH

WEST

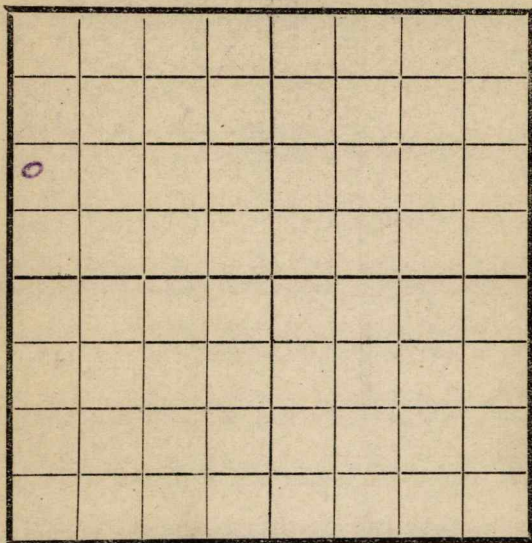

EAST

SOUTH

Location 250-W
 Rig Up 1070-S
 Drilling and remarks

RECORD

Cased _____ in. _____ Ft.
 Sand _____
 Gas _____
 Oil _____
 Total Depth _____


PRODUCTION

1st 24 hrs. Nat. _____
 1st 24 hrs. after shot _____
 Gas _____ Cu. Ft.
 Dry Hole _____
 Abandoned _____

Date

10/7, 1918 Bylee Scout

Map No. K10 Sec. 6 Twp. 27 R. 9
 Well No. 1 Baldwin
Edwards et al Company
 Contractor

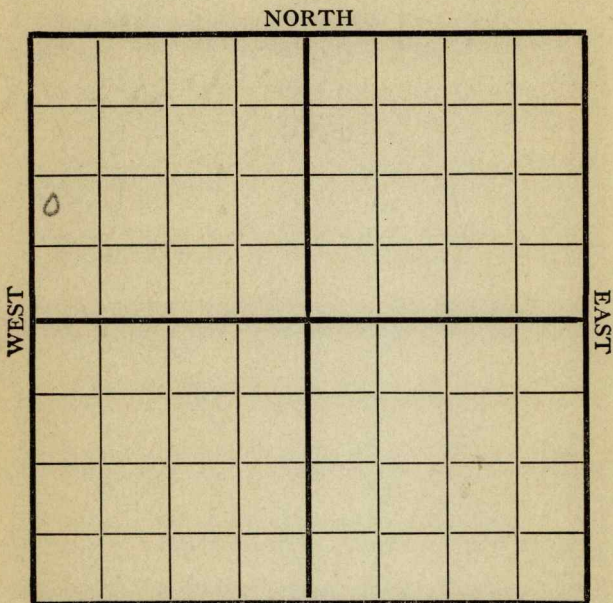1070 S250 E

Location _____

Rig up ☒ _____

Drilling and Remarks:

RECORD

Cased _____ in., _____ ft.

Sand _____

Gas _____

Oil _____

Total Depth _____

PRODUCTION

1st 24 hrs. Nat. _____

1st 24 hrs. after shot _____

Gas _____ Cu. Ft.

Dry Hole _____

Abandoned _____

Date

12/21918Cyle


Scout

Map No. K10 Sec. 6 Twp. 27^S R. 9^E
 Well No. 1 Baldwin
Edwards et al Company
 Contractor

NORTH

WEST

EAST

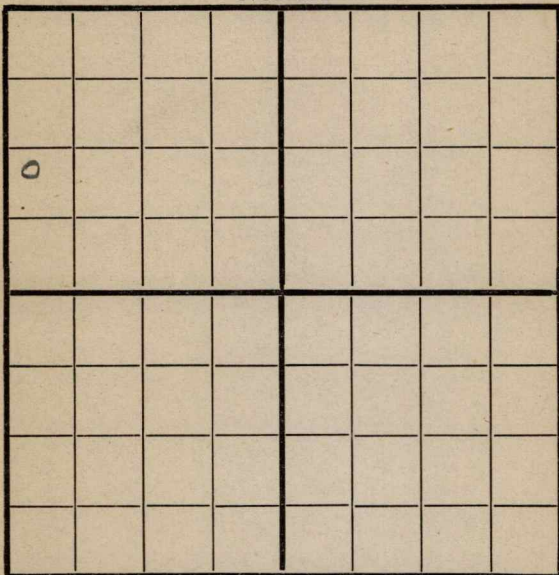

250 W

SOUTH

1070 S

Location _____

Rig up ☒

Drilling and Remarks:

RECORD

Cased _____ in., _____ ft.

Sand _____

Gas _____

Oil _____

Total Depth _____

PRODUCTION

1st 24 hrs. Nat. _____

1st 24 hrs. after shot _____

Gas _____ Cu. Ft.

Dry Hole _____

Abandoned _____

Date

3/8

191

9

Pyle

Scout


Map No. K10 Sec. 6 Twp. 27^S R. 9^EWell No. 1 BaldwinEdwards et al Company

Contractor

NORTH

WEST

EAST

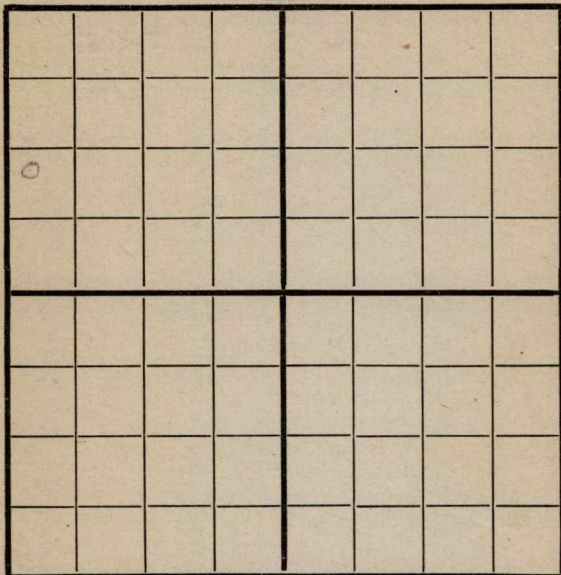

250 W

SOUTH

1070 S

Location _____

Rig up ☒

Drilling and Remarks:

RECORD

Cased _____ in., _____ ft.

Sand _____

Gas _____

Oil _____

Total Depth _____

PRODUCTION

1st 24 hrs. Nat. _____

1st 24 hrs. after shot _____

Gas _____ Cu. Ft.

Dry Hole _____

Abandoned _____

Date

3/15

1919

Pyle

Scout


Map No. K10 Sec. 6 Twp. 27 R. 9Well No. 1 Baldwin
Edwards et al Company

Contractor

NORTH

WEST

EAST

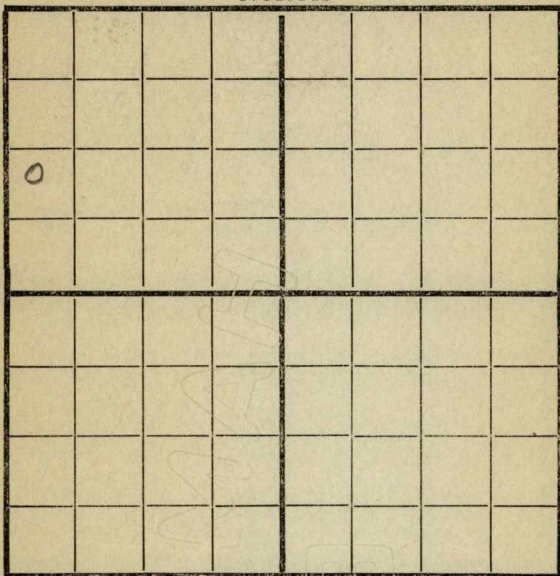

250 W

SOUTH

1070 S

Location _____

Rig up ☒

Drilling and Remarks:

RECORD

Cased _____ in., _____ ft.

Sand _____

Gas _____

Oil _____

Total Depth _____

PRODUCTION

1st 24 hrs. Nat. _____

1st 24 hrs. after shot _____

Gas _____ Cu. Ft.

Dry Hole _____

Abandoned _____

Date

3/18

1919

Pyle

Scout

Map No. K10 Sec. 6 Twp. 27 R. 9
 Well No. 1 Baldwin
Edwards et al Company
 Contractor

NORTH									
WEST									
SOUTH									
EAST									

250 W 1070 S

Location _____

Rig up ☒ _____

Drilling and Remarks:

RECORD

Cased _____ in., _____ ft.

Sand _____

Gas _____

Oil _____

Total Depth _____

PRODUCTION

1st 24 hrs. Nat. _____

1st 24 hrs. after shot _____

Gas _____ Cu. Ft.

Dry Hole _____

Abandoned _____

Date

3/21 1919

Pyle

Scout


Map No. K10 Sec. 6 Twp. 27 R. 9Well No. 1 Baldwin
Edwards et al Company

Contractor

NORTH

WEST

EAST

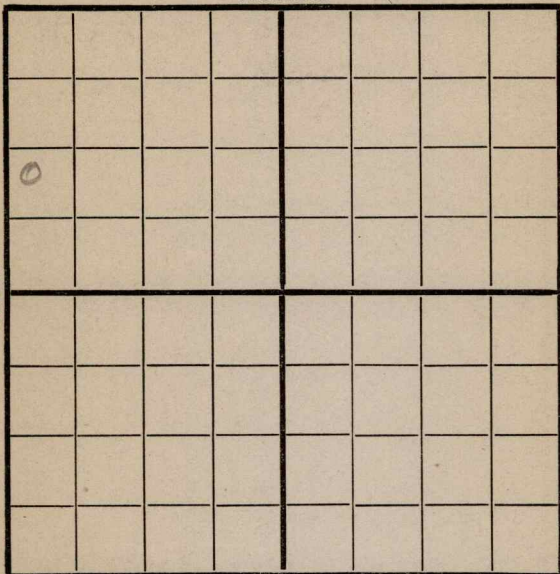

SOUTH

250 W

1070 S

RECORD

Location _____

Cased _____ in., _____ ft.

Rig up ☒ _____

Sand _____

Drilling and Remarks:

Gas _____

Oil _____

Total Depth _____

PRODUCTION

1st 24 hrs. Nat. _____

1st 24 hrs. after shot _____

Gas _____ Cu. Ft.

Dry Hole _____

Abandoned _____

Date

4/4

191

9

Pyle

Scout

Map No. K10 Sec. 6 Twp. 27 R. 9Well No. 1 Baldwin
Edwards et al Company

Contractor

NORTH

0							

WEST

EAST

250 W

SOUTH

10705

Location _____

Rig up ☒

Drilling and Remarks:

RECORD

Cased _____ in., _____ ft.

Sand _____

Gas _____

Oil _____

Total Depth _____

PRODUCTION

1st 24 hrs. Nat. _____

1st 24 hrs. after shot _____

Gas _____ Cu. Ft.

Dry Hole _____

Abandoned _____

Date


4/11

1919

Pyle

Scout

Map No. K10 Sec. 6 Twp. 27 R. 9
Well No. 1 Baldwin
Edwards et al Company
Contractor

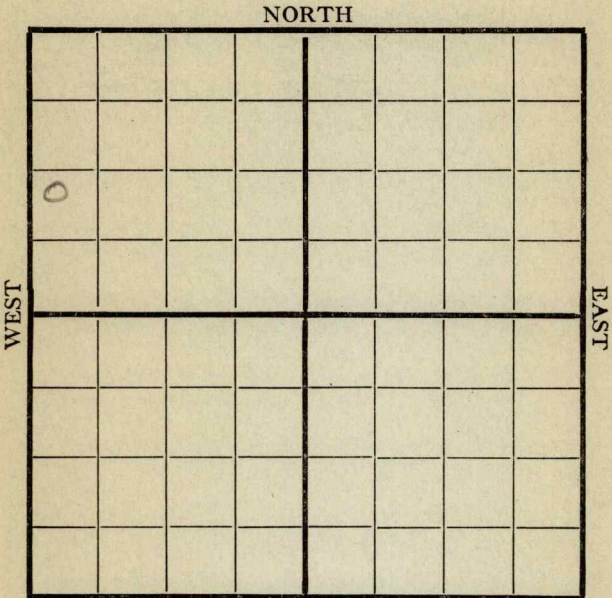


250 W SOUTH 10705

Location _____ Rig up ☒ Drilling and Remarks:	RECORD Cased _____ in., _____ ft. Sand _____ Gas _____ Oil _____ Total Depth _____
	PRODUCTION 1st 24 hrs. Nat. _____ 1st 24 hrs. after shot _____ Gas _____ Cu. Ft. Dry Hole _____ Abandoned _____

Map No. K10 Sec. 6 Twp. 27 R. 9
 Well No. 1 Baldwin
Edwards et al Company
 Contractor

NORTH

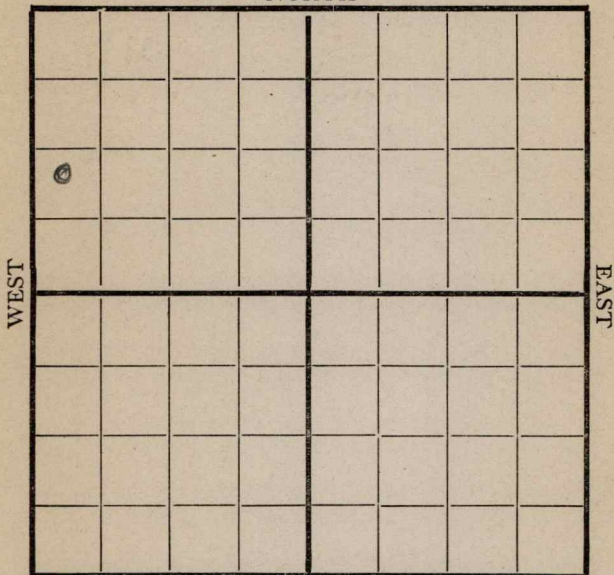

250 W

SOUTH

1070 S

Location _____

Rig up ☒ _____

Drilling and Remarks:

RECORD

Cased _____ in., _____ ft.

Sand _____

Gas _____

Oil _____

Total Depth _____

PRODUCTION

1st 24 hrs. Nat. _____

1st 24 hrs. after shot _____

Gas _____ Cu. Ft.

Dry Hole _____

Abandoned _____

Date

4/23 1919 Pyle Scout

Map No. K10 Sec. 6 Twp. 27 R. 9
 Well No. 1 Baldwin
Edwards et al Company
 Contractor

NORTH

0							

WEST

EAST

250 W

SOUTH 10705

Location _____

Rig up ☒

Drilling and Remarks:

RECORD

Cased _____ in., _____ ft.

Sand _____

Gas _____

Oil _____

Total Depth _____

PRODUCTION

1st 24 hrs. Nat. _____

1st 24 hrs. after shot _____

Gas _____ Cu. Ft.

Dry Hole _____

Abandoned _____

Date

5/8

1919

Pyle


Scout

Map No. K10 Sec. 6 Twp. 27 R. 9
 Well No. 1 Baldwin
Edwards et al Company
 Contractor

NORTH

WEST

EAST

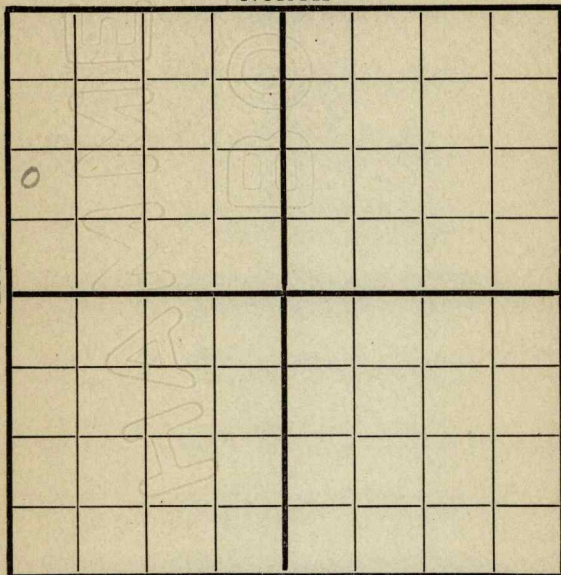

SOUTH

250 W

10705

RECORD

Location _____

Cased _____ in., _____ ft.

Rig up ☒

Sand _____

Drilling and Remarks:

Gas _____

Oil _____

Total Depth _____

PRODUCTION

1st 24 hrs. Nat. _____

1st 24 hrs. after shot _____

Gas _____ Cu. Ft.

Dry Hole _____

Abandoned _____

Date

5/18

1919

Pyle


Scout

Map No. K10 Sec. 6 Twp. 27 R. 9
 Well No. 1 Baldwin
Edwards et al Company
 Contractor

NORTH

WEST

EAST

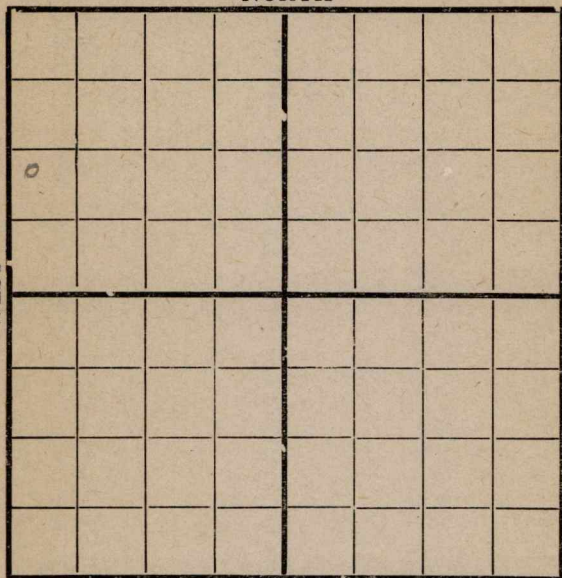

SOUTH

250 W10705

Location _____

Rig up ☒ _____

Drilling and Remarks:

RECORD

Cased _____ in., _____ ft.

Sand _____

Gas _____

Oil _____

Total Depth _____

PRODUCTION

1st 24 hrs. Nat. _____

1st 24 hrs. after shot _____

Gas _____ Cu. Ft.

Dry Hole _____

Abandoned _____

Date

5/7 191 9


Pyle

Scout

Map No. K10 Sec. 6 Twp. 27 R. 9

Well No. 1 Baldwin
Edwards et al Company
 Contractor

NORTH

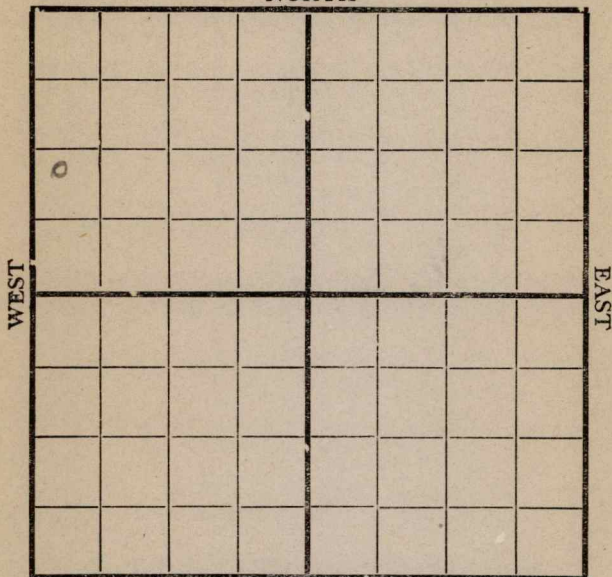

250 W

SOUTH

10705

Location _____

Rig up ☒ _____

Drilling and Remarks:

RECORD

Cased _____ in., _____ ft.

Sand _____

Gas _____

Oil _____

Total Depth _____

PRODUCTION

1st 24 hrs. Nat. _____

1st 24 hrs. after shot _____

Gas _____ Cu. Ft.

Dry Hole _____

Abandoned _____

Date

5/29 1919

Pyle

Scout

Map No. K10 Sec. 6 Twp. 27 R. 9
Well No. 1 Baldwin
Edwards et al Company
Contractor

NORTH

WEST

EAST

250 W SOUTH

10705

Location _____

Rig up ☒ _____

Drilling and Remarks:

RECORD

Cased _____ in., _____ ft.

Sand _____

Gas _____

Oil _____

Total Depth _____

PRODUCTION

1st 24 hrs. Nat. _____

1st 24 hrs. after shot _____

Gas _____ Cu. Ft.

Dry Hole _____

Abandoned _____

Date

6/6


191

9

Pyle

Scout

Map No. K10 Sec. 6 Twp. 27 R. 9
Well No. 1 Baldwin
Edwards et al Company
Contractor

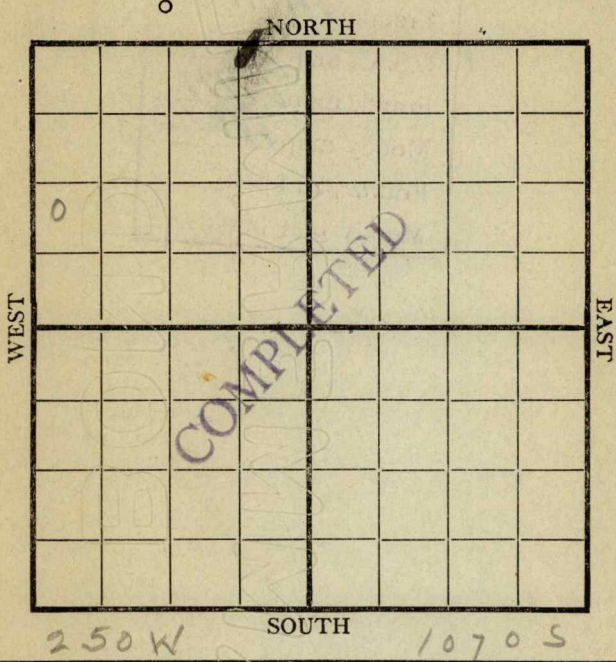

Location _____
Rig up ☒
Drilling and Remarks:
*Well drop
mounted well
is started*

RECORD	
Cased	_____ in., _____ ft.
Sand	_____
Gas	_____
Oil	_____
Total Depth	_____
PRODUCTION	
1st 24 hrs. Nat.	_____
1st 24 hrs. after shot	_____
Gas	_____ Cu. Ft.
Dry Hole	_____
Abandoned	_____

Date 6/11 1919 Pyle Scout

Map No. K10 Sec. 6 Twp. 27 R. 9Well No. 1 Baldwin
Edwards et al Company

Contractor

SECTION PLAT

Ft. from N. Line

1070' Ft. from S. Line

Ft. from E. Line

250 Ft. from W. Line

o			

Location

Rig up

Drilling and Remarks:

*Pig moved
away*

RECORD

Cased _____ in., _____ ft.

Sand _____

Gas _____

Oil _____

Total Depth _____

PRODUCTION

1st 24 hrs. Nat. _____

1st 24 hrs. after shot _____

Gas _____ Cu. Ft.

Dry Hole _____

Abandoned _____

Date

11/9 1919

Pyle

Scout