


Section 35 Township 32 Range 2 EWell No. #1 Donley "B"Company A. D. Allison

NORTH

WEST

EAST

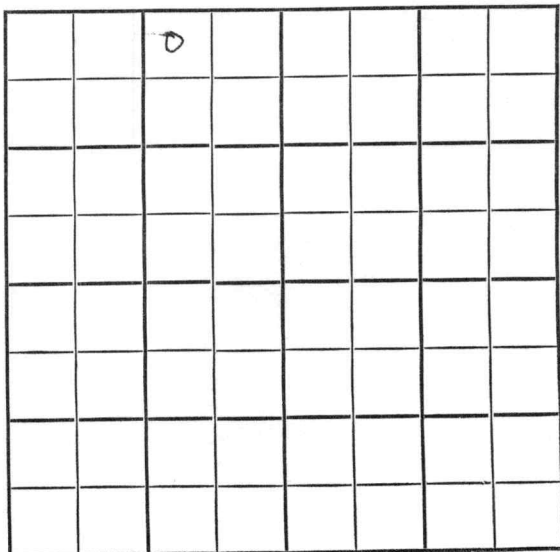

SOUTH

Sumner

KANSAS

SEC. 35	TWP. 32	R. 2E
------------	------------	----------

WELL NO.

#1 Donley "B"

FARM

COMPANY

A. D. Allison

CONTRACTOR

Capitt


_____ Ft. from N. Line

_____ Ft. from S. Line

_____ Ft. from E. Line

_____ Ft. from W. Line

NW NE NW

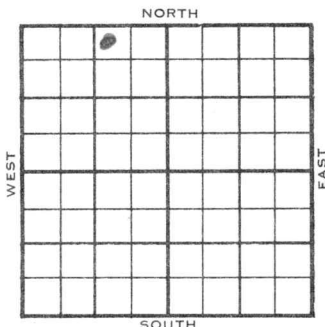

1955

ELEVATION

1177'

REPORT

8/3

8" @92 Drlg 1660

FIRST REPORT

8-17

DST 2 640-50 open 1 hr. Rec. 700 ' wtr. D & A

Ank. Stal. 2204 1027, Tp. Layton 2586
1409 K.C. 2656 1479 BKC Cleve 2860
1683 M. Chert 3108 1931, K. 3511 2334
S. 3562 2385 A 3576 2399 T.D. 3600

ABANDONED

TOPS	DEPTH	LOG	DATUM	Loc. in Sec.
Anh.				NW NE NW
Tr.				
Dg.				
Bl.				
L.				Geol.
K.C.				Contr.
B.K.C.				Capitt
Ce.				
C.				Pool
M.				
M.				
K.				
Mz.				
Mq.				
V.				
S.				
S.				
A				
R.				
Pe.				
G.				
T.D.				

Lse.

No.

10 R

FIRST REPORT

AUG 3 '38

8" @ 92 drlg. 1660

R

County Sumner Elev. 1177
Sec. 35 Twp. 32 Rge. 2E
Company A. D. Allison
Farm Name Donley "B" No. 1

TOPS	DEPTH	LOG	DATUM
Anh. <u>Stal</u>	<u>2204</u>		<u>1027</u>
Tp. <u>Layton</u>	<u>2586</u>		<u>1409</u>
H.			
Tr.			
Dg.			
BL.			
L.			
K.C.	<u>2656</u>		<u>1479</u>
B.K.C. <u>C/eye</u>	<u>2860</u>		<u>1685</u>
Ce.			
C.			
M. <u>Chart</u>	<u>3108</u>		<u>1931</u>
M.			
K.	<u>3511</u>		<u>2334</u>
Mz.			
Me.			
V.			
S.	<u>3562</u>		<u>2385</u>
S.			
A.	<u>3576</u>		<u>2399</u>
R.			
PE.			
G.			
T.D.	<u>3600</u>		

Loc. in Sec. NW NE NW
Geol. _____
Contr. _____
Capitt
Pool _____



Date Comm. AUG 17 1955
8" @ 92 DST 2 640-50 open 1 hr.
Rec. 700' wtr.

D & A