

Lane

KANSASSection 21 Township 18 Range 30WWell No. #1 ArmantroutCompany Continental Oil

NORTH

WEST

EAST

0							

SOUTH

Lane

KANSAS

Sec. 21 Twp. 18 R. 30 W

Well No. # 1 Armantrout Farm

Continental Oil

Company

Contractor

Wildcat


Ft. from N. Line

330 Ft. from S. Line

Ft. from E. Line

530 Ft. from W. Line

SW SW SW
PEPL - DHM

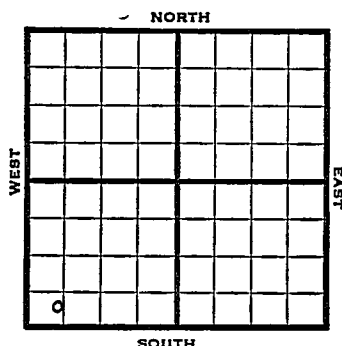

1951


Elev. 2881' REPORT

11/7
12/19

RUR
Spud 11-9-51
D&A TD 5157'
16" @ 355 9-/58" @ 1792'
Heeb. 3879 KC 3917
DST 4194-4205 open $\frac{1}{2}$ hr.
Rec. 1400' SW
DST 4335-65 open 1 hr.
Rec. 8' mud
Viola 5080 Marm. 4344
Miss. 4542 Arb. 5119-57 TD
D&A

ABANDONED

County Lane State Kansas
 Sec. 21 (Blk.) 18 (Sur.) 30W Map No.
 Operator Continental Oil
 Well No. 1 Farm Armantrout
 Elev. _____ Location SW SW SW

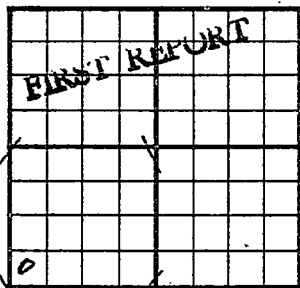

330 Ft. From S Line SW

530 Ft. From W Line Quarter

1st. Report NOV 7 1951

Completion


Remarks PEPL-DIM

Spudding Date

Drlg. Data Wildcat

RUR

J. E. TYRA

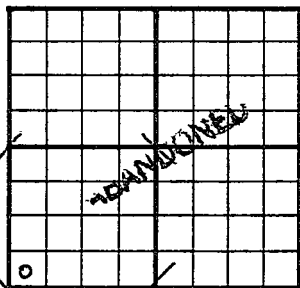County _____ Lane _____ State KansasSec. 21 (Blk. Twp.) 18 (Sur. Rge.) 30W Map No.Operator Continental OilWell No. 1 Farm ArmantroutElev. 2881 Location SW SW SW330 Ft. From S Line SW530 Ft. From W Line Quarter

1st. Report _____

Completion DEC 1 9 1951Remarks WildeatSpudding Date 11-9-51Drilg. Data D & A TD 515716" @ 355 9 5/8" @ 1792Heeb. 3879 KC 3917 DST 4194-4205open 1/2 hr. Rec. 1400' sw DST 433565 open 1 hr. Rec. 8' mudViola 5080 Marm. 4344 Miss. 4542Arb. 5119-57 TDD & A

J. E. TYRA