


DX 78-1 Greeley

KANSAS

Section 21 Township 18 Range 39W

Well No. #1 Frankhauser

Company Geo B. Caulkins

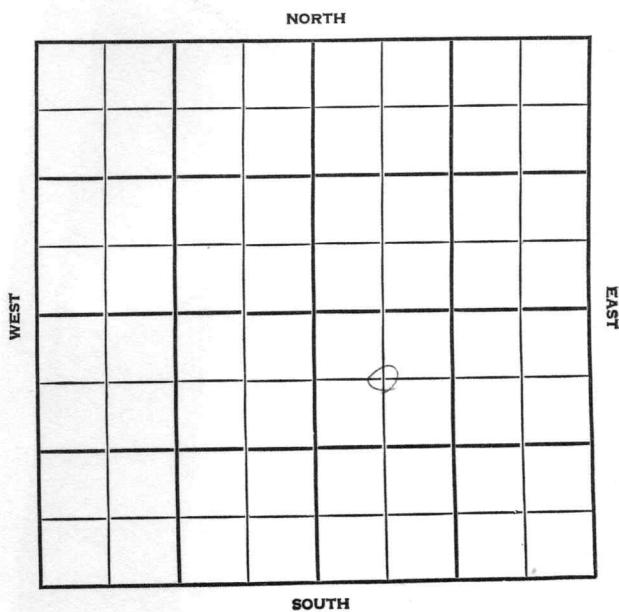

Greeley

KANSAS

SEC.

21

TWP.

18

R.

39W

WELL NO.

#1 Frankhauser

FARM

COMPANY

Geo. B. Caulkins

CONTRACTOR

Rine Drlg.

WILDCAT

____ FT. FROM N. LINE

2110


____ FT. FROM S. LINE

1880

____ FT. FROM E. LINE

____ FT. FROM W. LINE

C NW SE

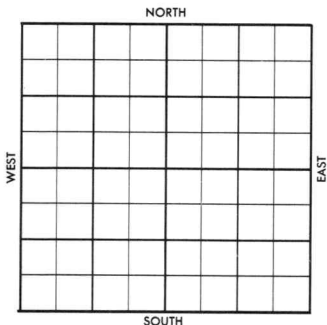

Carter - FO

1956

ELEVATION

3475'

REPORT

5-29

Comm. 5-26-56
 13" @ 418 w/350
 WOC

-6-6

DST 2850-2910, op 60 min, rec 840'sw
 BHP 60/ 20"
 Drlg. 4820'

6-20

Log
 D & A
 Marm 4350', Ce. 4610', Atoka 4785',
 Mw. Sh. 4920', Mw. Sd. 5060'
 Log: Chase 3212', Tp. 3908',
 L. 4196', Marm 4354',
 Ce. 4586', Atoka 4776',
 Mw. Sh. 4908', Mw. Sd. 5062',
 Miss. 5170'

TD 5200'

ABANDONED

County Greeley Elev. 3475
 Sec. 21 Twp. 18 Rge. 39W
 Company Geo. B. Caulkins
 Farm Name Frankhauser No. 1

TOPS	DEPTH	LOG	DATUM	Loc. in Sec.
Anh.				C NW SE
Tp.				2110' SL
H.				1880' EL
Tr.				
Dg.				
BL.				
L.				Geol.
K.C.				Contr.
B.K.C.				Rine Drlg.
Ce.				
C.				
M.				Pool
M.				Wildcat
K.				
Mz.				
Me.				
V.				
S.				
S.				
A.				
R.				
PE.				
G.				
T.D.				

Date Comm. 5-26-56 Carter FD

13" @ 418/350 WOC



JUN 2 1956

34

County Greeley Elev. 3475
 Sec. 21 Twp. 18 Rge. 39W
 Company Geo. B. Caulkins
 Farm Name Frankhauser No. 1

TOPS	DEPTH	LOG	DATUM	Loc. in Sec.
Anb.				
Tp. <u>Chase</u>		<u>3212</u>		<u>C NW SE</u>
H. <u>TP</u>		<u>3908</u>		<u>2110' SL</u>
Tr.				<u>1880' EL</u>
Dg.				
Bl.				
L.		<u>4196</u>		
N.C.				Geol.
R.K.C.				Contr.
Ce. <u>Marm</u>	<u>4350</u>	<u>4354</u>		<u>Rine Drl.</u>
C.C.	<u>4610</u>	<u>4586</u>		
M. <u>Hoka</u>	<u>4785</u>	<u>4776</u>		
M. <u>Mw sh</u>	<u>4920</u>	<u>4908</u>		
K. <u>MWsd</u>	<u>5060</u>	<u>5062</u>		Pool
Mz. <u>MISS</u>		<u>5170</u>		<u>Wildcat</u>
Ma.				
V.				
S.				
S.				
A.				
R.				
Pe.				
G.				
ED.	<u>5200</u>	<u>5205</u>		

ABANDONED

JUN 20 1956

Date Comm. 5-26-56 Carter FD

13" @ 118/350 WDC JUN 6 '56

DST 2850 -

2910 (60) 840' SW

BHP 60(20)

3350 8" 2602

JUN 13 '56

44820 JUN 20 '56 409

D & A