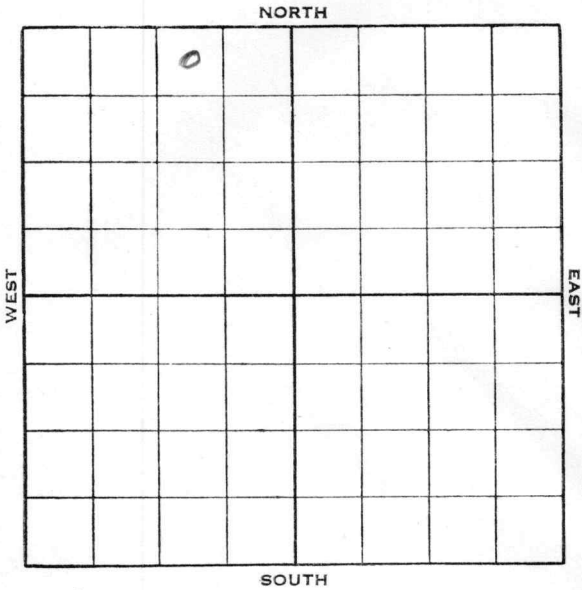



Section 4 Township 32 Range 3-EWell No. 4 WilsonCompany Wakefield

KANSAS

Cowley

Sec. 4 Twp. 32 R. 3-EWell No. #4 Wilson Farm
Wakefield Company330 Ft. from N. Line Ft. from S. Line990 Ft. from E. Line Ft. from W. Line

Elev. 1189

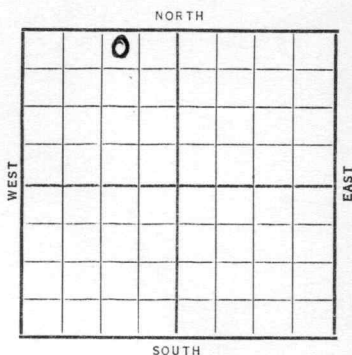

Date

REPORT

1938

6/22

B.O.R.

7/1

Drlg. 100'

7/8

15" - 544'. Drlg. 860'.

7/15

S. D. 1275'.

7/22

12" - 1292'. Dlg. 1505'.

7/29

10" - 1825'. 8" - 2168'.

Dlg. 2205'.

8/5

8" - 2517'. Dlg. 2522'.

8/12

8" - 2560'. S. O. 2695-2705'.

Dlg. 2885'.

8/19

7" - 3227'. WOC.

8/24

7" at 3227'.

Arb. 3231'.

T. D. 3256' S. W.

P. B. 3252'.

Pump 399 bbls. 4 hrs. & 443 bbls.

4 hours.

Potential 2391 bbls.

COMPLETED

Cowley KANSAS

Map No. 1 Sec. 4 Twp. 32 R. 3EWell No. 4 WilsonWakefield

Company _____

FIRST REPORT

Contractor _____

SECTION PLAT

NW NE NW

330 Ft. from N. Line

_____ Ft. from S. Line

990 Ft. from E. Line

_____ Ft. from W. Line

	0		

Location _____

Rig up _____

Drilling and Remarks:

BCR

RECORD

Cased _____ in., _____ ft.

Sand _____

Gas _____

Oil _____

Total Depth _____

PRODUCTION

1st 24 hrs. Nat. _____

1st 24 hrs. after shot _____

Gas _____ Cu. Ft.

Dry Hole _____

Abandoned _____

Date

JUN 22 1938

19

H. D. Hatfield Scout

Cowley

KANSAS

Map No. 1 Sec. 4 Twp. 32 R. 3EWell No. 4 WilsonWakefield

Company

Contractor

COMPLETED

NW NE NW

330 Ft. from N. Line Ft. from S. Line990 Ft. from E. Line Ft. from W. Line

SECTION PLAT

	0		

Location

RECORD

Cased 7 in., 3227 ft.Sand 4-6 3231Gas Oil Total Depth 3256PRODUCTION S.W.1st 24 hrs. Nat. 1st 24 hrs. after shot Gas Cu. Ft.Dry Hole Abandoned

Date

AUG 24 1938

19

H. D. Hatfield Scout