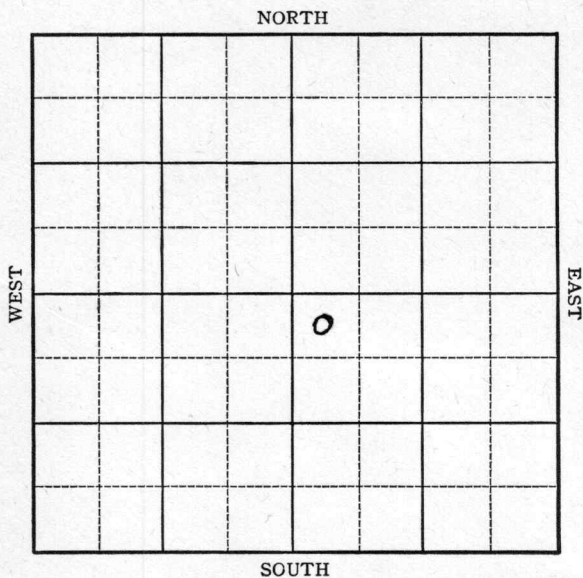


KANSAS

Summer

Section 36 Township 32 Range 2EWell No. 2 JamesCompany Ashland Et al.

KANSAS

Sumner County

Sec. 36 Twp. 32 R. 2E

Well No. #2 James Farm

Ashland et al Company

Miscellaneous


330 Ft. from N. Line

_____ Ft. from S. Line

_____ Ft. from E. Line

330 Ft. from W. Line

NW SE

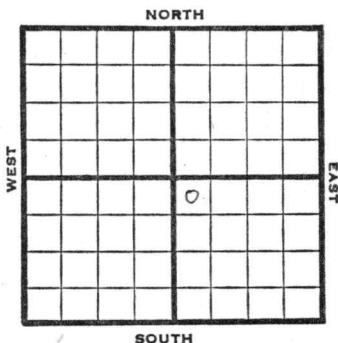

1946 Elev. 1135' REPORT

6/5 Location

6/12 "

6/18 "

6/26 10" @ 240'
Drlg 650'

7/3 KC 2685
Miss 3180'
Drlg 3270'

7/9 SL M 3459-65
KC 2691
Simp 3445'
5" @ 3464, RUST
Miss 3186
Arb 3464-65 TD

7/16 TD 3470'

7/23 Swb 5 oil PH SW

7/30 " "

8/6 " "

8/13 " "

8/20 " "

8/27 " "

9/5 Arb 3464'

5" @ 3464'

TD 3470'

Pump 35 Pot

41.9 Grav.

COMPLETED

KANSASKansas Pool Name MiscellaneousMap No. Sec. 36 Twp. 32 R. 2EWell No. 2 JamesAshland Etal. CompanyFIRST REPORT Contractor

NW SE

SECTION PLAT

330 Ft. from N. Line Ft. from S. Line Ft. from E. Line330 Ft. from W. Line

		0	

Sumner CountyLocation XRig up

Drilling and Remarks:

RECORD

Cased in., ft.Sand Gas Oil Total Depth

PRODUCTION


1st 24 hrs. Nat. 1st 24 hrs. after shot Gas Cu. Ft.Dry Hole Abandoned

Date

JUN 5 1946 19S. J. LEWIS Scout

Pool Name Miscellaneous
KansasMap No. 1 Sec. 36 Twp. 32 R. 2EWell No. 2 JamesAshland et al. CompanyCOMPLETED Contractor

NW SE

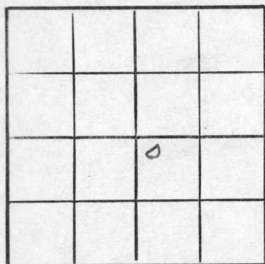E 1, 1135
SECTION PLAT330 Ft. from N. Line Ft. from S. Line Ft. from E. Line330 Ft. from W. LineSumner CountyLocation Rig up

Drilling and Remarks:

Art 34645" 3464Pump 35 Pst41 2/3

RECORD

Cased in., ft.Sand Gas Oil Total Depth 3470

PRODUCTION

1st 24 hrs. Nat. 1st 24 hrs. after shot Gas Cu. Ft.Dry Hole Abandoned

Date

SEP 5 1946 19 S. J. LEWIS Scout