

KANSAS


FORM 51 5M 6-46 PETROL

Sumner County

Section 36 Township 32 Range 2E

Well No. 3 James

Company Ashland Ref. etal

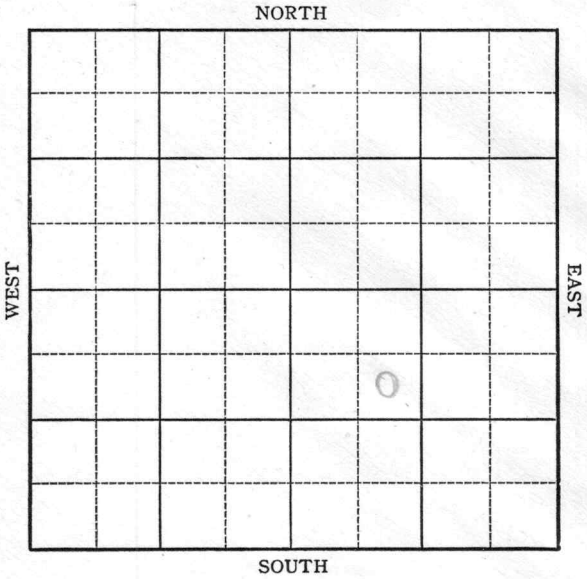

KANSAS

Summer County

Sec. 36 Twp. 32 R. 2E

Well No. #3 James Farm

Ashland Ref. et al Company

Miscellaneous


990 Ft. from N. Line

 Ft. from S. Line

 Ft. from E. Line

990 Ft. from W. Line

SE NW SE

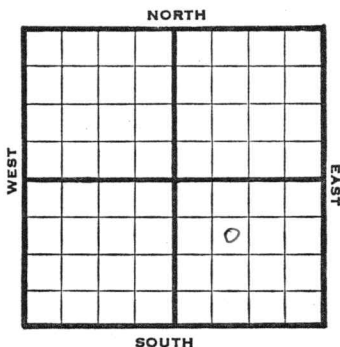

1946

1129

REPORT

7/31	10" @ 250	
	Drlg. 775'	
8/6	Drlg 3175'	
8/13	Miss 3218'	
	Simp 3491	
	Arb 3502	
	TD 3573-	
	5" @ 3502 RUST SWD	
8/20	"	"
8/27	"	"
9/5	"	"
9/10	"	"
9/18	"	"
9/25	Arb 3502'	
	5" @ 3502'	
	Miss 3226'	
	TD 3573'	
	Perf Miss	
	Pump 20 POT	
	Grav 39	

COMPLETED

Kansas

Pool Name

Miscellaneous

KANSAS

Map No. _____ Sec. 36 Twp. 32 R. 2E

Well No. 3 James

Ashland Ref. etal.


Company

FIRST REPORT

Contractor

SE NW SE

SECTION PLAT

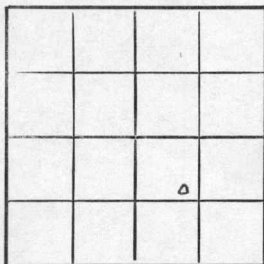

990 Ft. from N. Line

Ft. from S. Line

Ft. from E. Line

990 Ft. from W. Line

Sumner County

RECORD

Location

Cased _____ in., _____ ft.

Rig up

Sand _____

Drilling and Remarks:

Gas _____

10" @ 250'

Oil _____

drlg. 775

Total Depth _____

PRODUCTION

1st 24 hrs. Nat. _____

1st 24 hrs. after shot _____

Gas _____ Cu. Ft.

Dry Hole _____

Abandoned _____

Date

JUL 3 1 1946

19

S. J. LEWIS

Scout

SVSNVX

Kansas Pool Name MiscellaneousMap No. / Sec. 36 Twp. 32 R. 2EWell No. 3 JamesAshland Ref. etal. Company**COMPLETED**

Contractor

SE NW SE

E11129

SECTION PLAT

990 Ft. from N. Line Ft. from S. Line Ft. from E. Line990 Ft. from W. LineSumner CountyLocation Rig up

Drilling and Remarks:

*Art 80002**5" 80002**Min 3226**Prof Min**July 20 25**892 24***RECORD**Cased in., ft.Sand Gas Oil Total Depth 80002**PRODUCTION**1st 24 hrs. Nat. 1st 24 hrs. after shot Gas Cu. Ft.Dry Hole Abandoned

Date

SEP 25 1946

19

S. J. LEWIS

Scout